
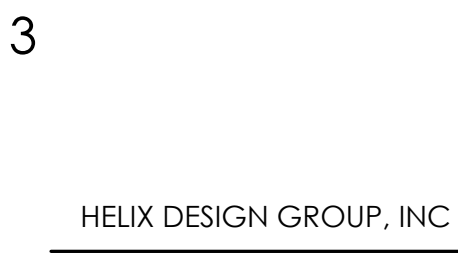
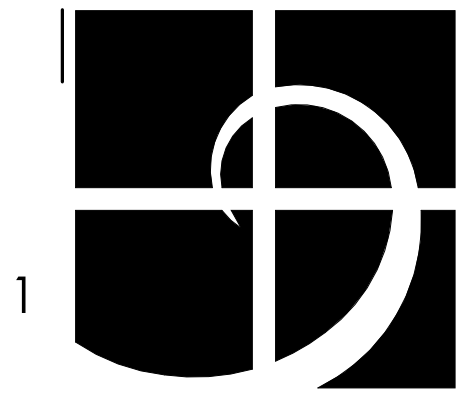


6/29/2022 3:46:16 PM
C:\Users\ella\Desktop\Rent 2022 Projects\A22-065 Golden Stone
PROJECT: A22-065 - GOLDEN STONE OFFICE BUILDING
9th Ave As Built-A_122_ellalampy\2370.rvt
PLOTTER:

GOLDEN STONE OFFICE BUILDING - Second Floor

33400 9th Ave S, Federal Way, WA 98003

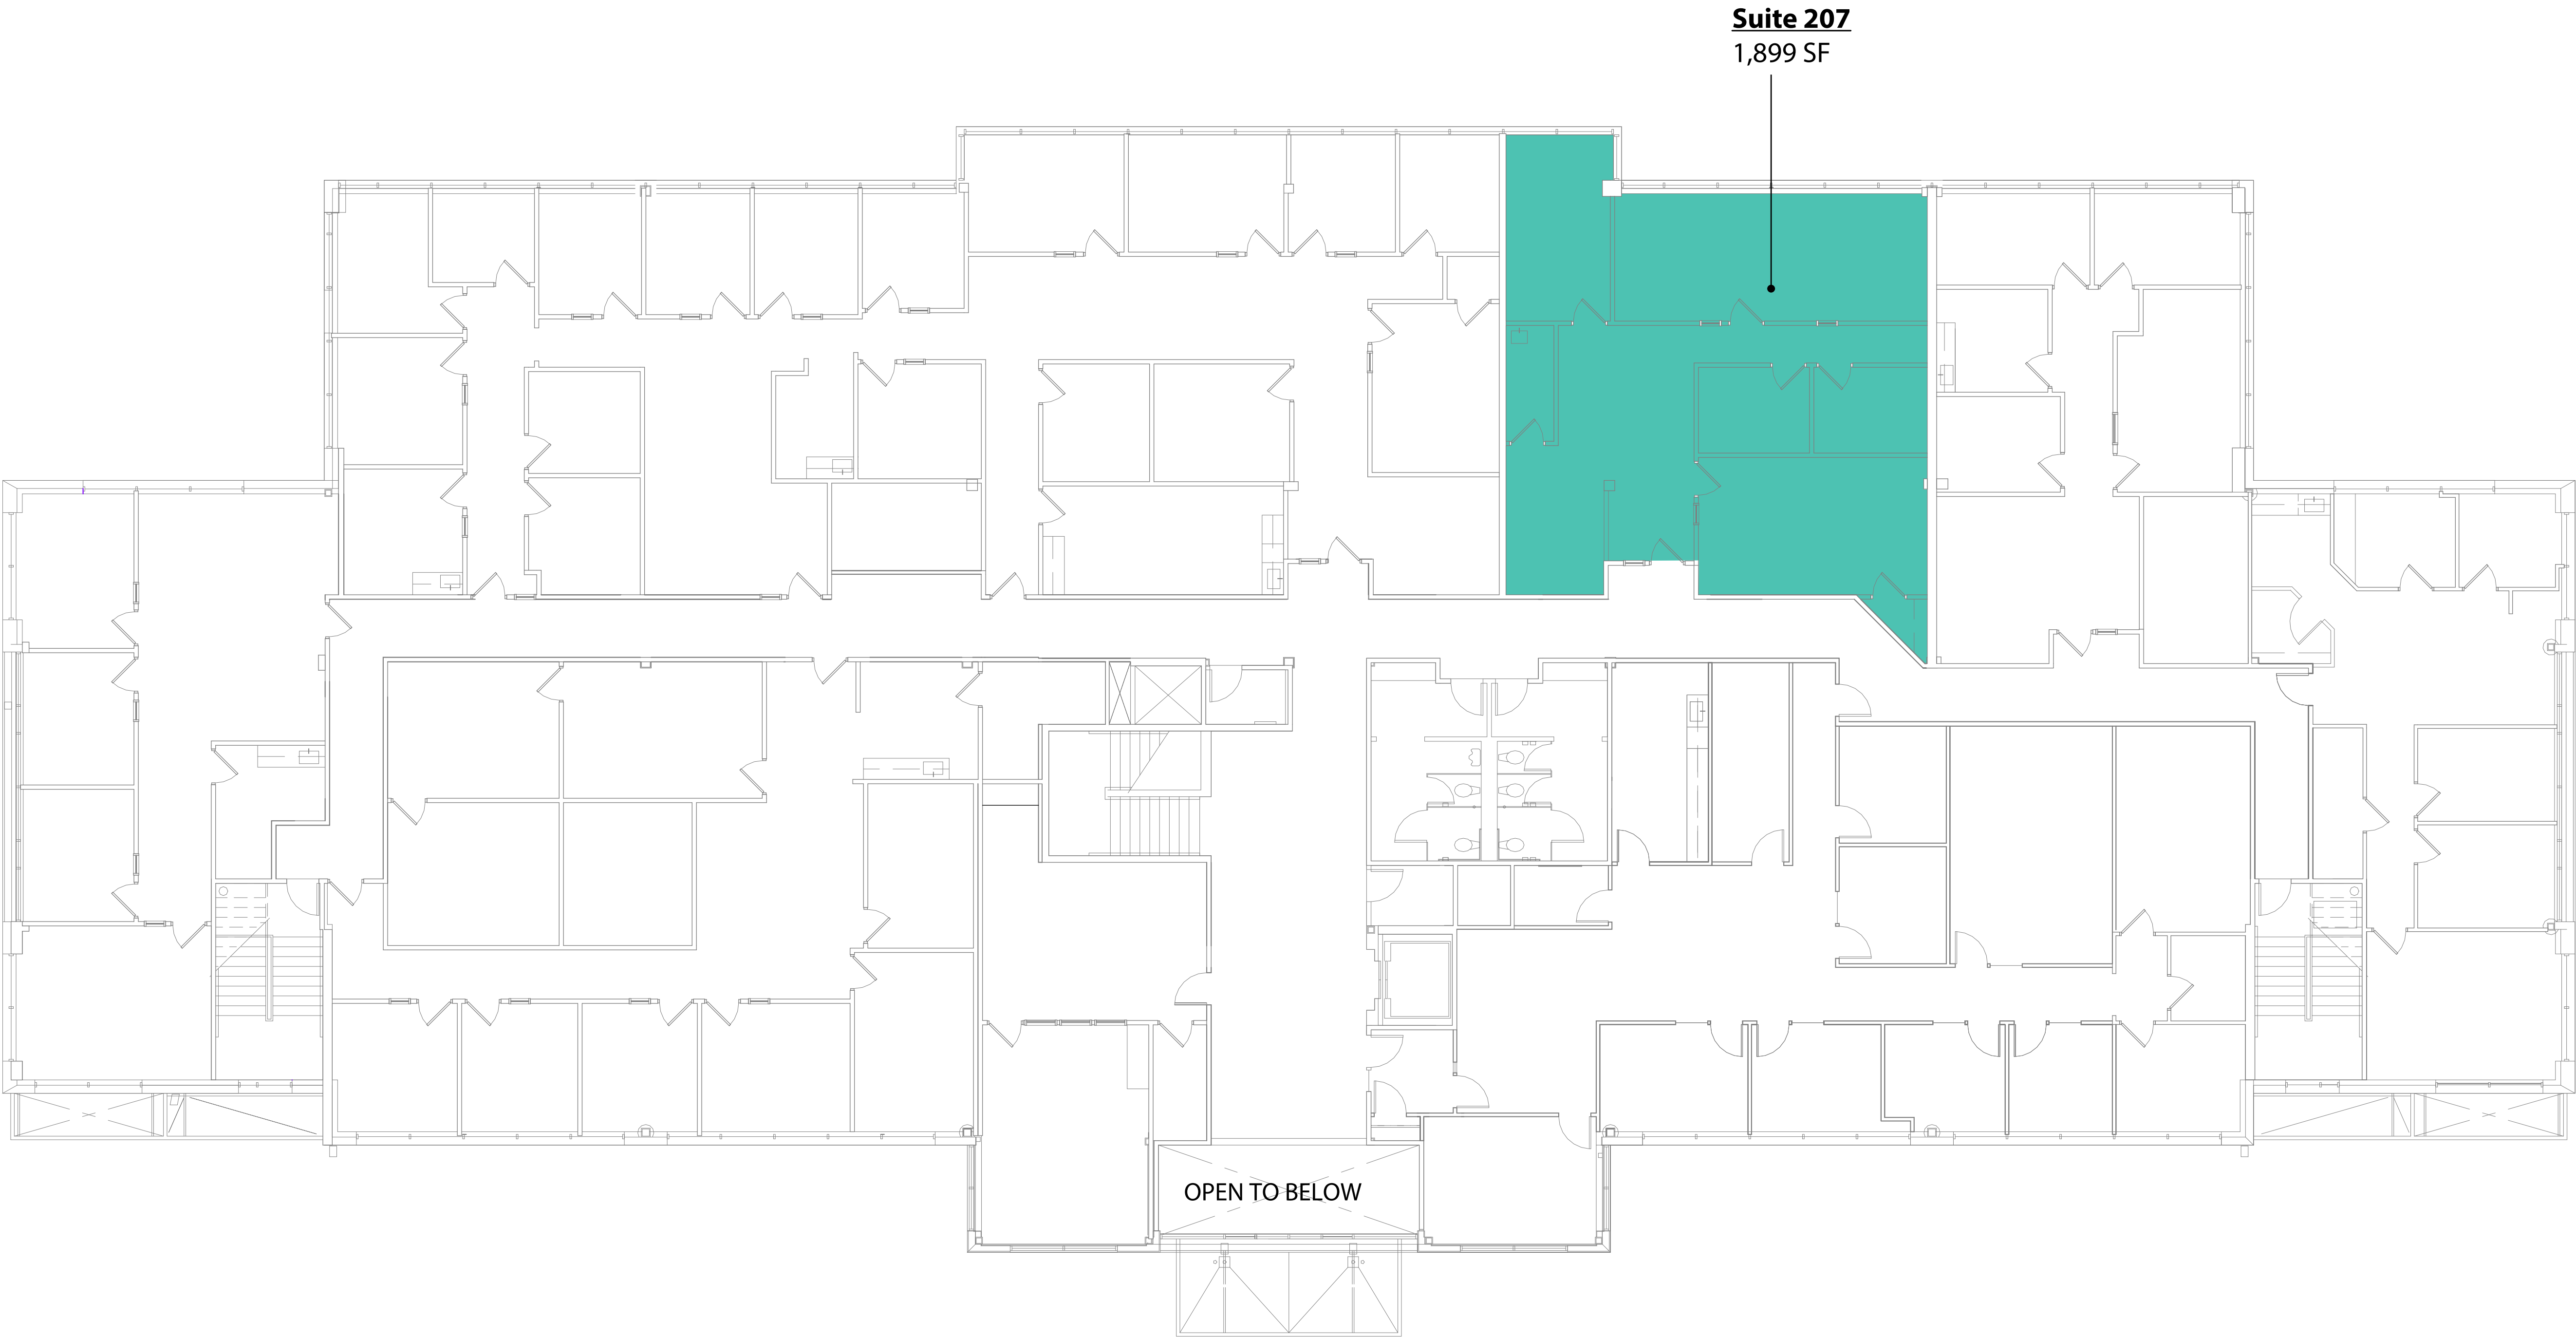

7 BOMA PLANS

8 GOLDEN STONE
OFFICE BUILDING
33400 9TH
AVENUE SOUTH

FEDERAL WAY, WASHINGTON	
REVISION	DATE

9	
DATE	JOB NO.
06.29.22	a22-065
AS-BUILT DRAWINGS	

10 G003
WHITE

DRAWING NO.
©HELIUS DESIGN GROUP, INC.: All rights reserved. No part of this document may be reproduced in any form or by any means without permission in writing from Helix Design Group.



ROSEN HARBOTTLE
COMMERCIAL REAL ESTATE