

**Helix**  
design group



AMERICAN INSTITUTE OF ARCHITECTS

3

HELIX DESIGN GROUP, INC

4

5

6

7 BOMA PLANS

GOLDEN STONE  
OFFICE BUILDING  
33400 9TH  
AVENUE SOUTH

FEDERAL WAY, WASHINGTON  
REVISION DATE

9


DATE JOB NO.  
06.29.22 a22-065  
AS-BUILT DRAWINGS

10 G003  
WHITE

DRAWING NO.  
© HELIX DESIGN GROUP, INC.: All rights reserved. No part of this document may be reproduced in any form or by any means without permission in writing from Helix Design Group.

**Suite 100**  
5,698 SF

**Suite 116**  
960 SF

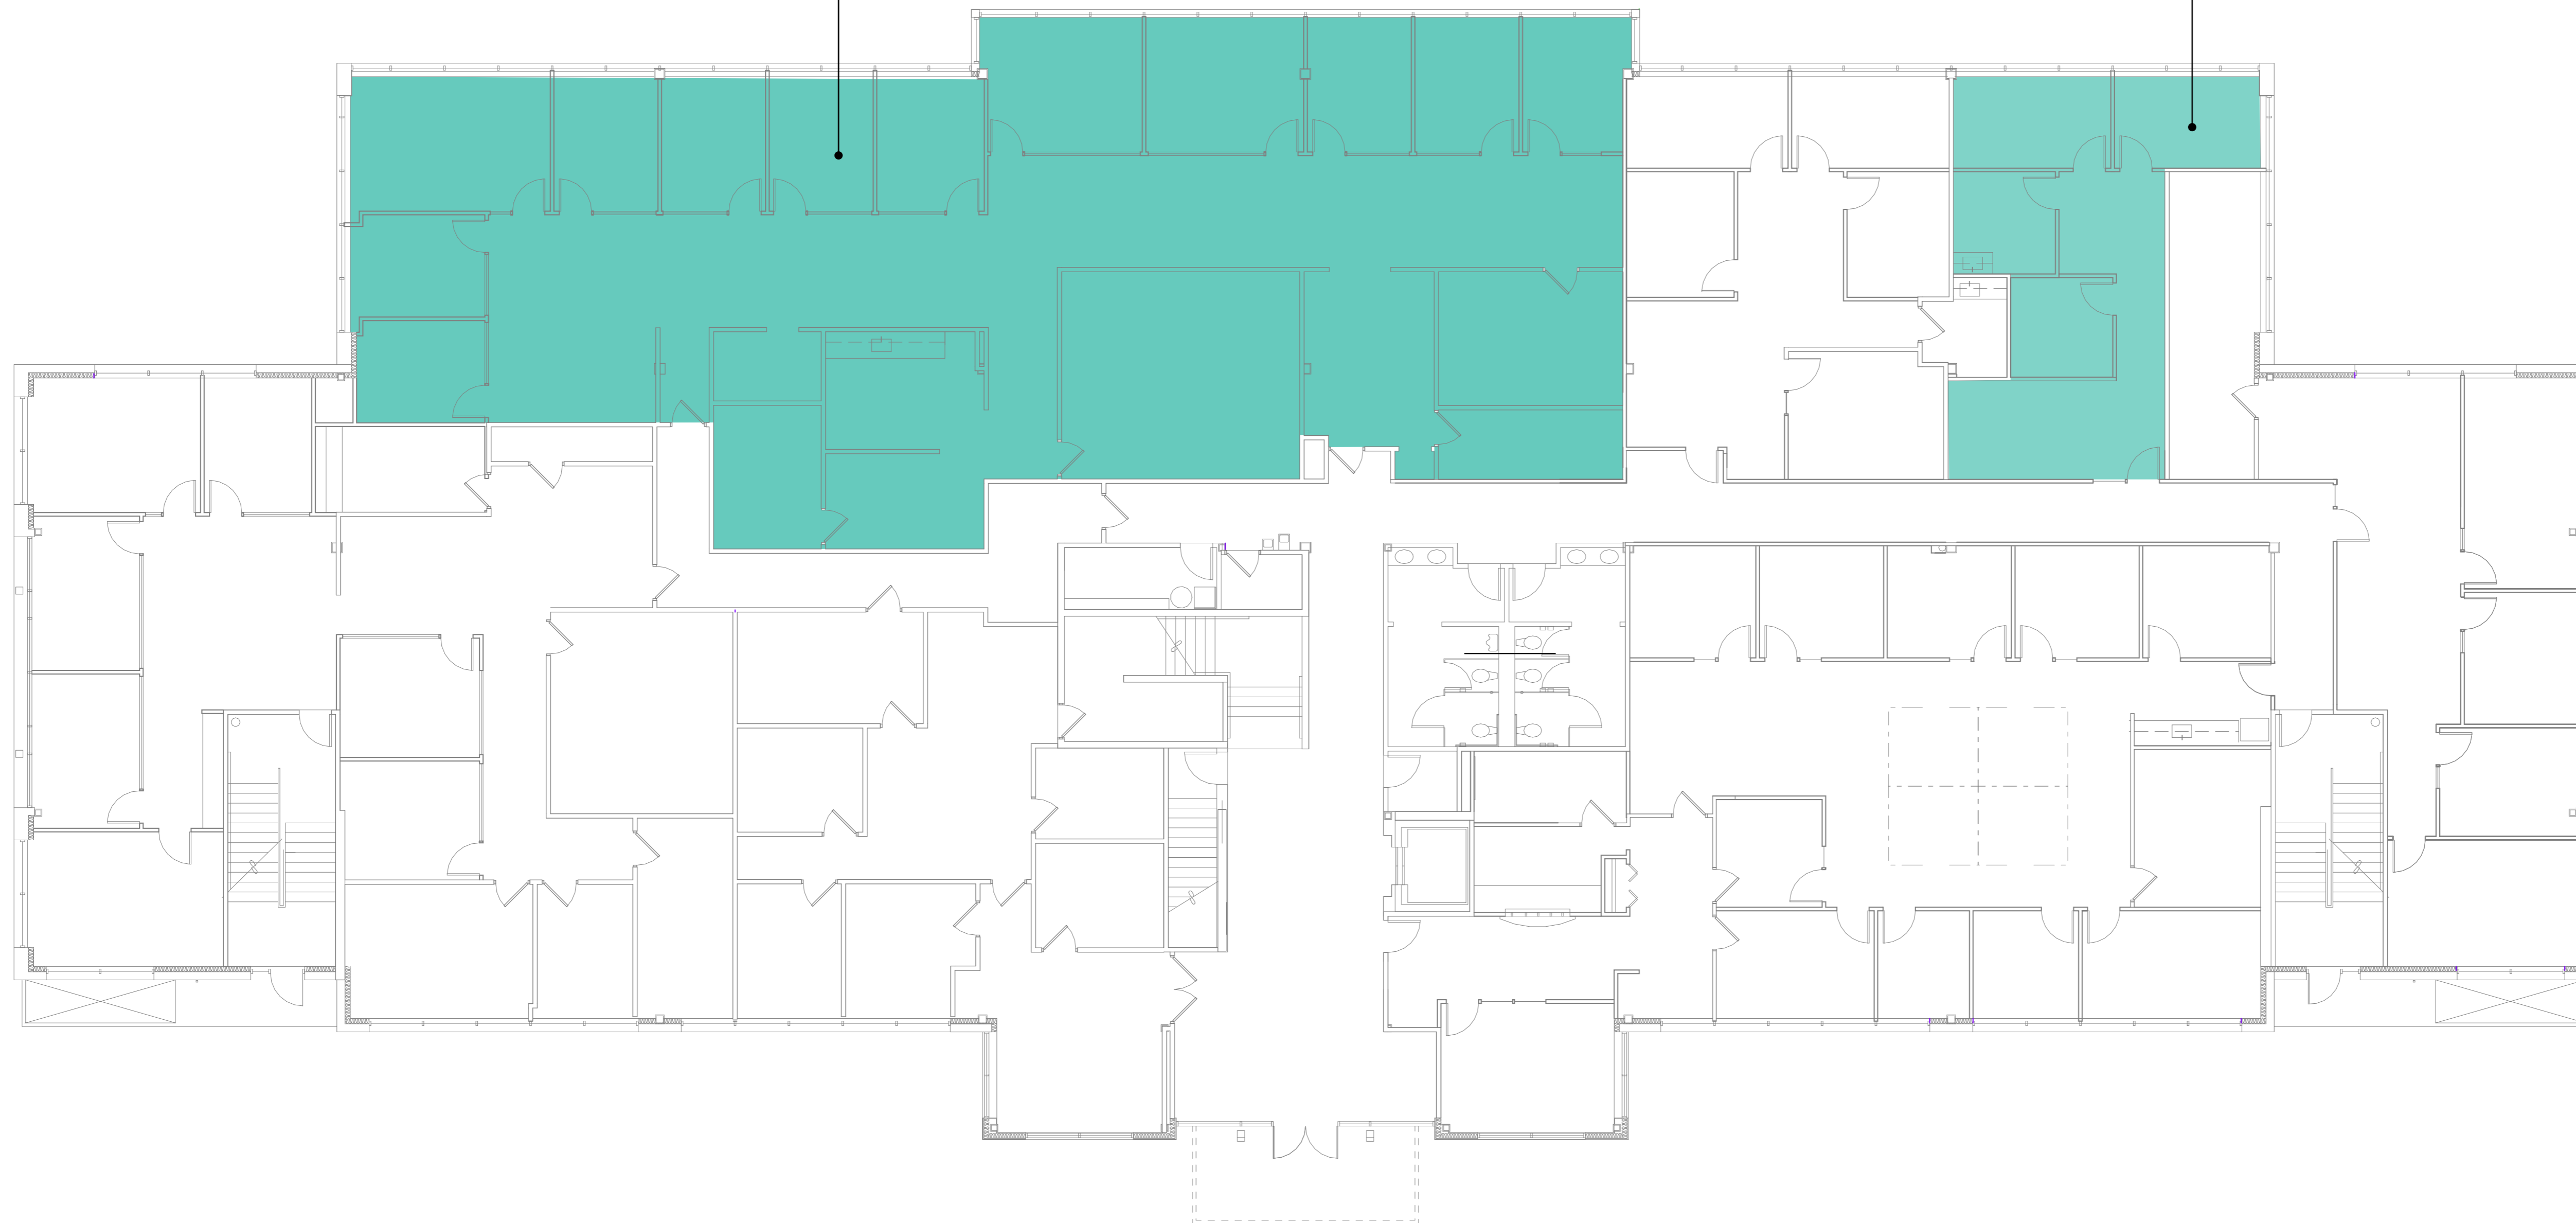

PROJECT: 422-065 - GOLDEN STONE OFFICE BUILDING  
9th Ave As Built - A\_122\_ellampy/2379.rvt  
6/29/2022 3:46:16 PM  
FILE PATH: C:\Users\ellampy\Desktop\Revit 2022\Projects\422-065 Golden Stone

# GOLDEN STONE OFFICE BUILDING - First Floor

33400 9th Ave S, Federal Way, WA 98003



**ROSEN HARBOTTLE**  
COMMERCIAL REAL ESTATE