


**Helix**  
design group



AMERICAN INSTITUTE OF ARCHITECTS

HELIX DESIGN GROUP, INC

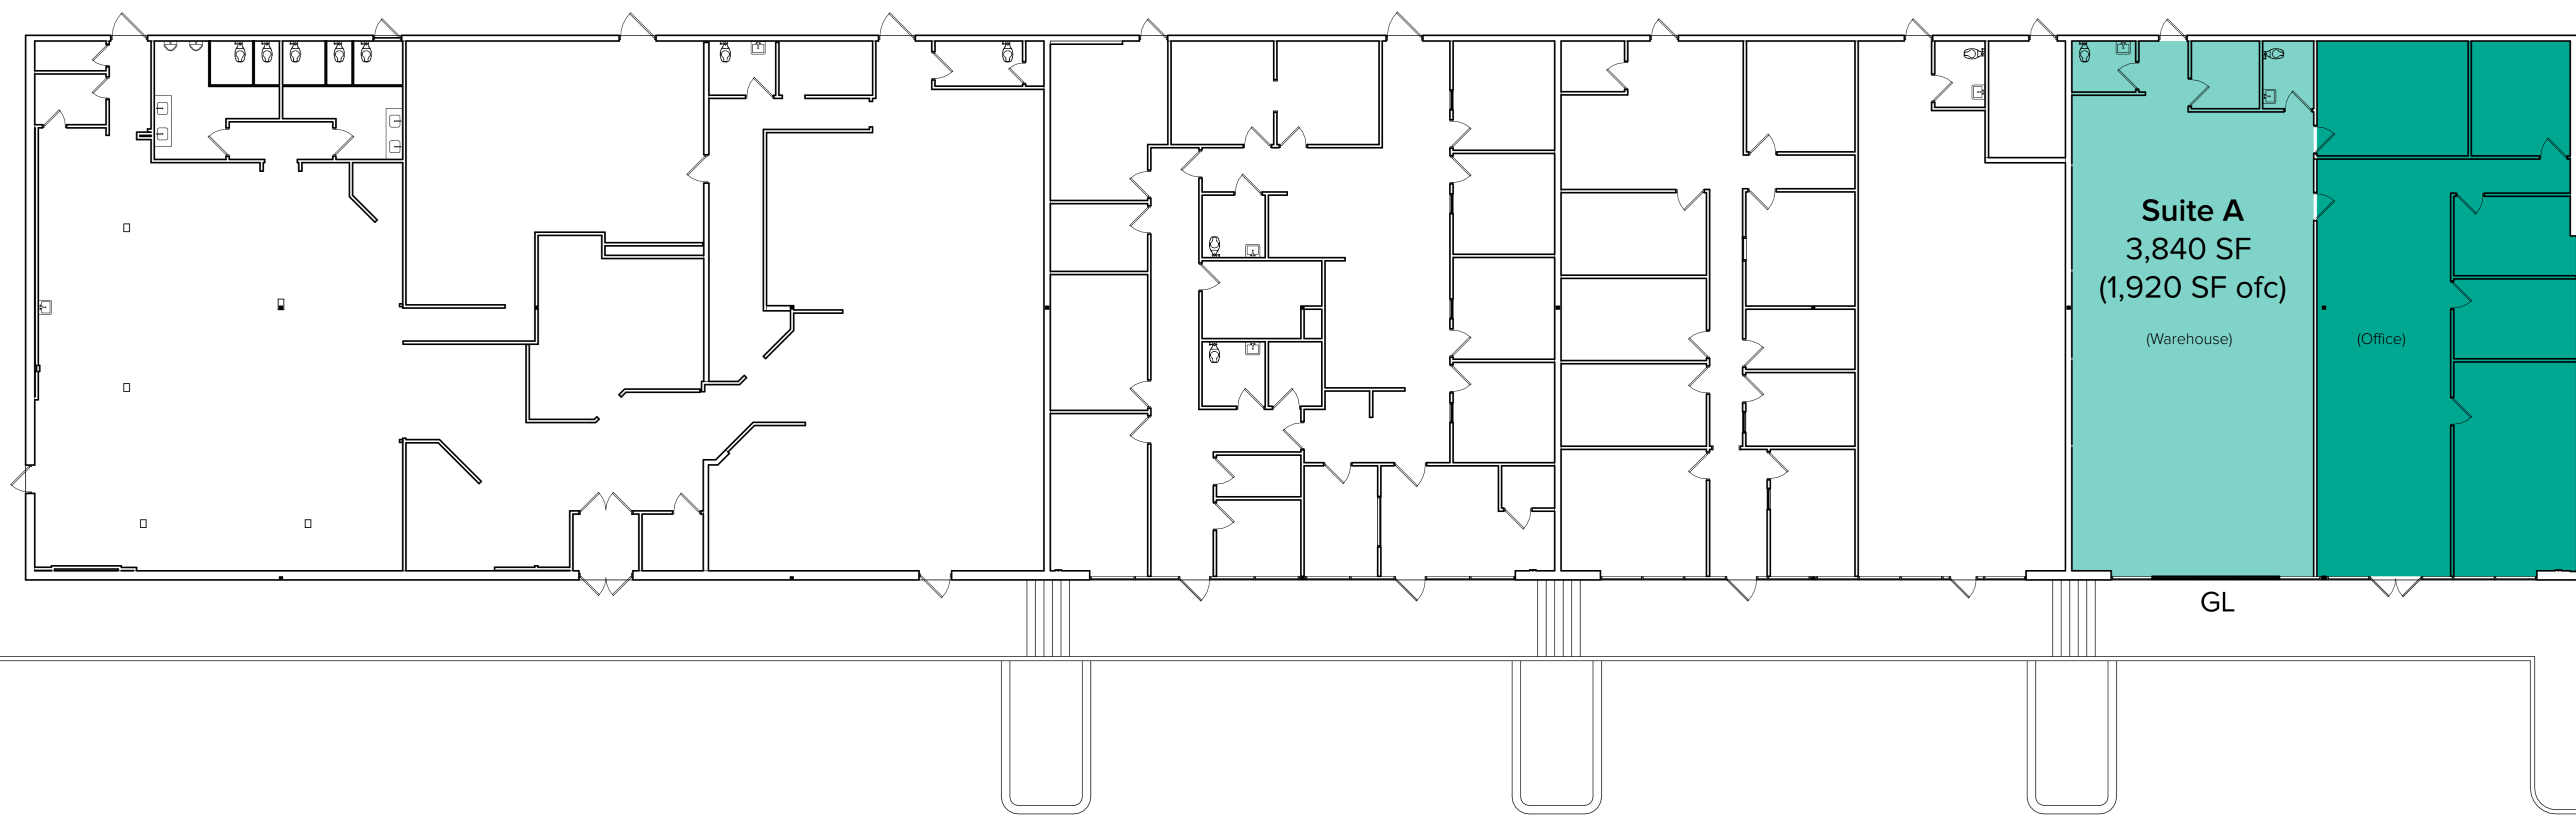

GL

7 FLOOR PLAN

8 CEDAR PLAZA  
BUILDING A

TACOMA, WASHINGTON

REVISION	DATE

DATE	JOB NO.
03.25.22	q22-022

AS-BUILT DRAWINGS  
00% PROGRESS  
LATEST SET REVISION

10 A100  
WHITE

DRAWING NO.  
© HELIX DESIGN GROUP, INC.: All rights reserved. No part of this document may be reproduced in any form or by any means without permission in writing from Helix Design Group.

PROJECT: 422-022 - CEDAR PLAZA  
P:\Cedar Plaza\422-022 Cedar Plaza A-Building\01 Drawings\03 BIM Models\422-022 Cedar Plaza A-Building\422-022.rvt  
4/6/2022 10:58:20 AM  
FILE PATH:

# Cedar Plaza - Building A

## 3630 South Cedar Street, Tacoma, WA 98409

