


Helix
design group



AMERICAN INSTITUTE OF ARCHITECTS

HELIX DESIGN GROUP, INC

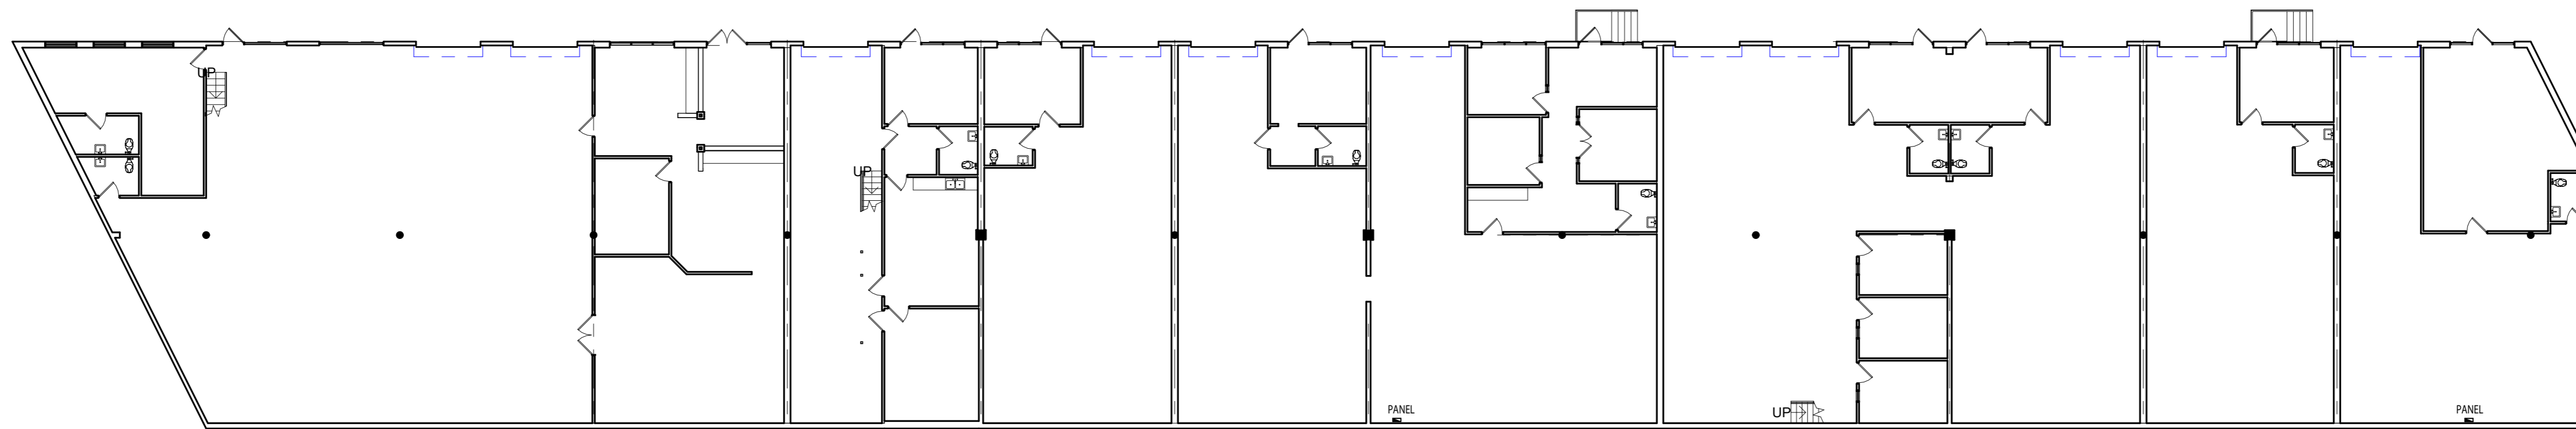

5A LOWER FLOOR PLAN - 3635 S Lawrence Street
1/16" = 1'-0"



10A UPPER FLOOR PLAN - 3640 S Cedar Street
1/16" = 1'-0"

7 FLOOR PLAN

8 CEDAR PLAZA
BUILDING D


TACOMA, WASHINGTON

REVISION	DATE

DATE 03.25.22 JOB NO. 022-022

AS-BUILT DRAWINGS
00% PROGRESS
LATEST SET REVISION

10 A100
WHITE

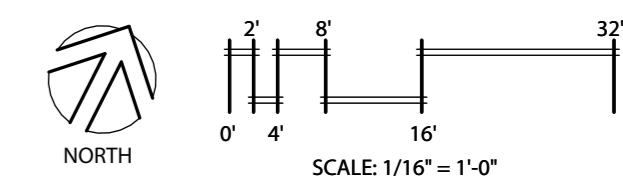

4/6/2022 9:58:16 AM PROJECT: 022-022 - CEDAR PLAZA
\\hdx-01\file1\Projects\Cedar Plaza\022-022\Cedar Plaza As-Built\01 Drawings\03 BIM Models\022-022\Cedar Plaza As-Built\BldgD-A_722.rvt

Cedar Plaza - Building D
3635 South Lawrence Street & 3640 South Cedar Street, Tacoma, WA 98409



DRAWING NO.
©HELIX DESIGN GROUP, INC.: All rights reserved. No part of this document may be reproduced in any form or by any means without permission in writing from Helix Design Group.