


Helix
design group



AMERICAN INSTITUTE OF ARCHITECTS

HELIX DESIGN GROUP, INC

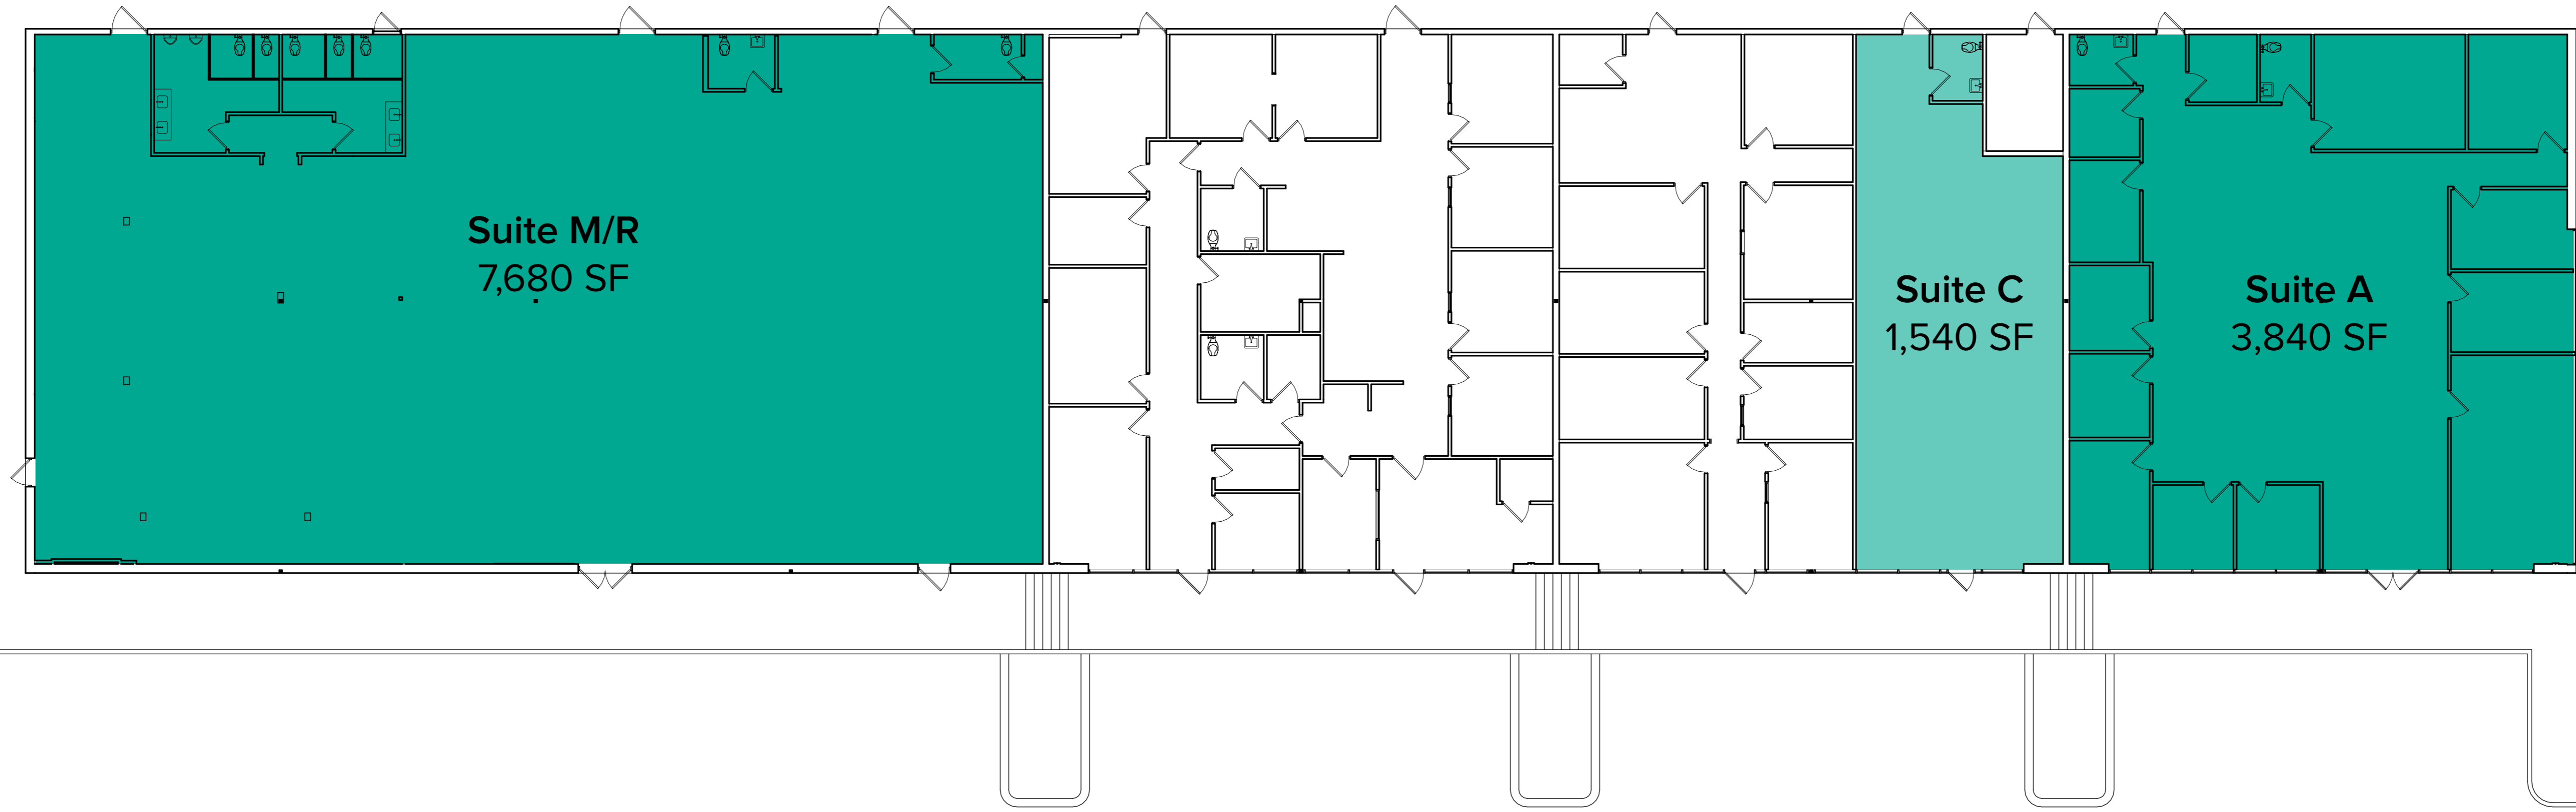

7 FLOOR PLAN

8 CEDAR PLAZA
BUILDING A

TACOMA, WASHINGTON

REVISION	DATE

DATE: 03.25.22 JOB NO.: a22-022

AS-BUILT DRAWINGS
00% PROGRESS
LATEST SET REVISION
A100
WHITE

DRAWING NO. © HELIX DESIGN GROUP, INC. All rights reserved. No part of this document may be reproduced in any form or by any means without permission in writing from Helix Design Group.

PROJECT: 422-022 - CEDAR PLAZA
P:\Cedar Plaza\422-022 Cedar Plaza A-Building A Drawings\03 BIM Models\422-022 Cedar Plaza A-Building A.dwg
DATE: 4/6/2022 10:58:20 AM
FILE PATH:

Cedar Plaza - Building A

3630 South Cedar Street, Tacoma, WA 98409

