


Suite D  
1,800 SF  
(909 SF ofc)

4

5

5A LOWER FLOOR PLAN - 3635 S Lawrence Street  
1/16" = 1'-0"

6

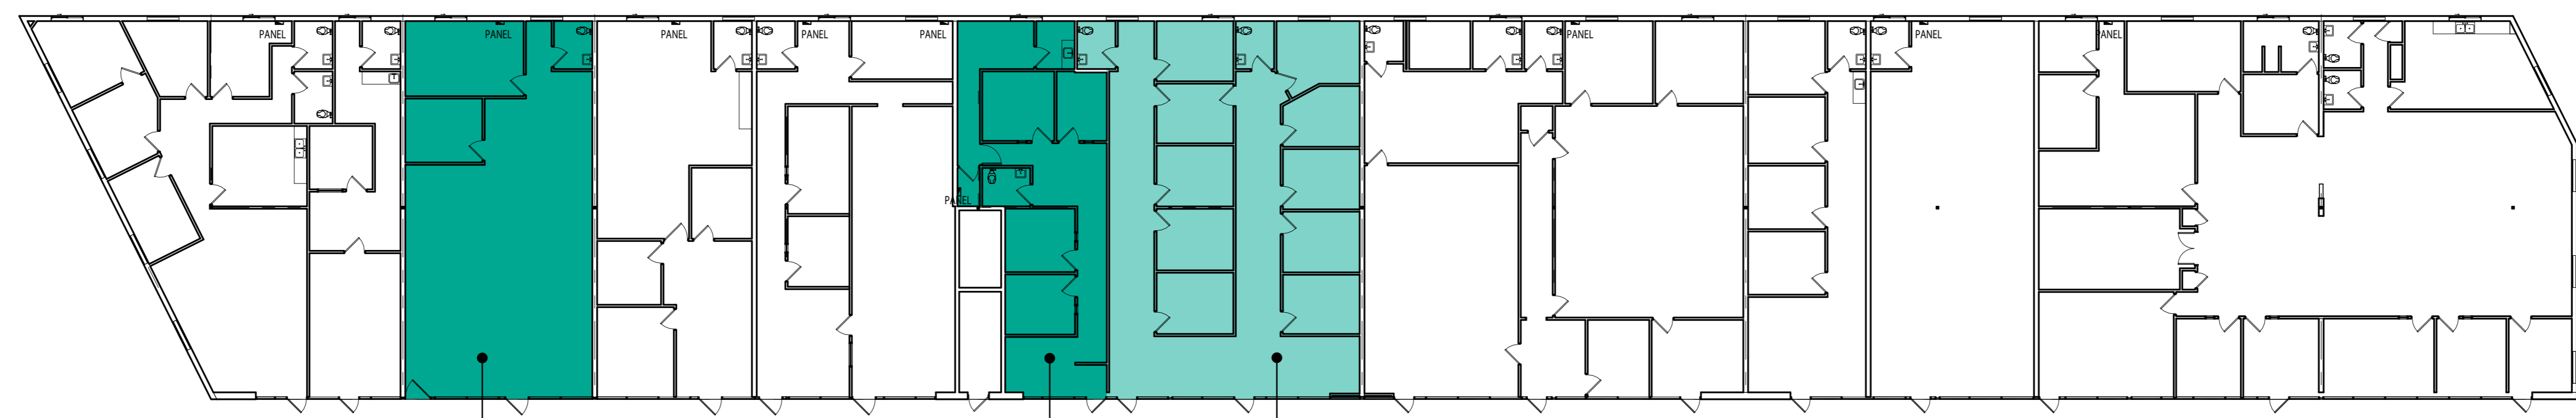

Suite U  
1,800 SF

Suite P  
1,240 SF

Suite M/O  
2,427 SF

7 FLOOR PLAN

8 CEDAR PLAZA  
BUILDING D

TACOMA, WASHINGTON

REVISION	DATE

9

DATE 03.25.22 JOB NO. 022-022

AS-BUILT DRAWINGS  
00% PROGRESS  
LATEST SET REVISION

10A UPPER FLOOR PLAN - 3640 S Cedar Street  
1/16" = 1'-0"

10

PLOTTED: 4/6/2022 9:58:16 AM PROJECT: 022-022 - CEDAR PLAZA  
 \\hpj-rf-file1\Projects\Cedar Plaza\022-022 Cedar Plaza As-Built\01 Drawings\03 BIM Models\022-022 Cedar Plaza As-Built\BldgD-A\_722.rvt