


Helix  
design group



AMERICAN INSTITUTE OF ARCHITECTS

HELIX DESIGN GROUP, INC

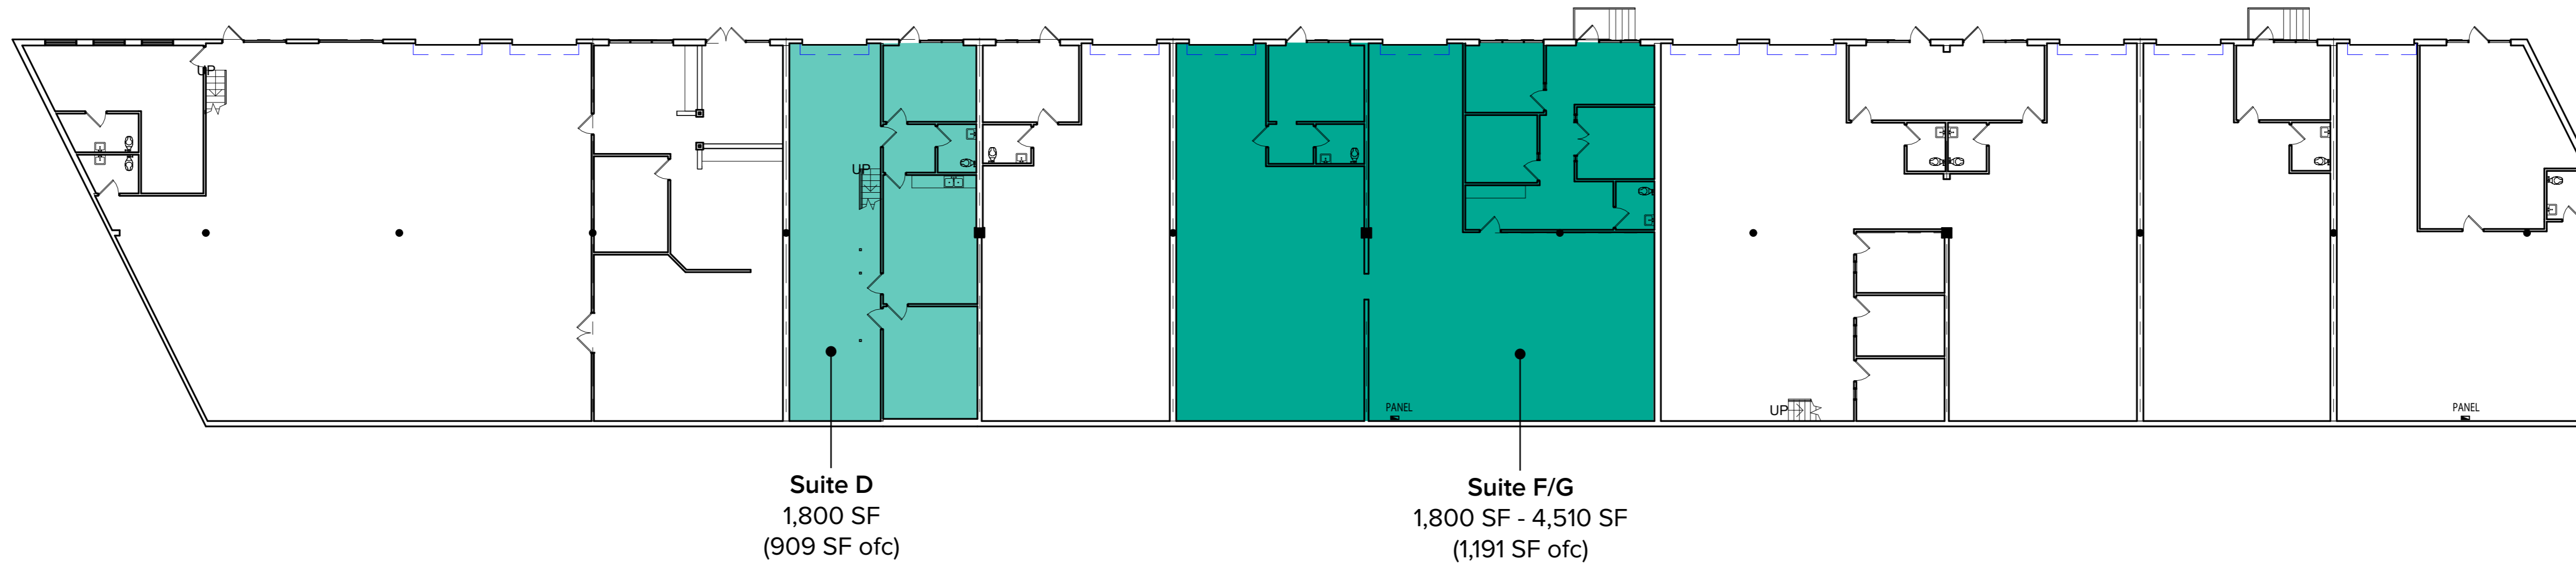

5A LOWER FLOOR PLAN - 3635 S Lawrence Street  
1/16" = 1'-0"



10A UPPER FLOOR PLAN - 3640 S Cedar Street  
1/16" = 1'-0"

FLOOR PLAN

CEDAR PLAZA  
BUILDING D

TACOMA, WASHINGTON

REVISION	DATE

DATE: 03.25.22 JOB NO. a22-022

AS-BUILT DRAWINGS  
00% PROGRESS  
LATEST SET REVISION

10 A100  
WHITE

DRAWING NO.  
©HELIX DESIGN GROUP, INC.: All rights reserved. No part of this document may be reproduced in any form or by any means without permission in writing from Helix Design Group.

4/6/2022 9:58:16 AM PROJECT: a22-022 - CEDAR PLAZA  
\\hpj-rf-1\Projects\Cedar Plaza\22-022 Cedar Plaza As-Built\01 Drawings\03 BIM Models\22-022 Cedar Plaza As-Built\BldgD-A\_722.rvt

Cedar Plaza - Building D  
3635 South Lawrence Street & 3640 South Cedar Street, Tacoma, WA 98409

