

Helix
design group



AMERICAN INSTITUTE OF ARCHITECTS

3

HELIX DESIGN GROUP, INC

4

5

6

7 FLOOR PLAN

8 CEDAR PLAZA
BUILDING D

TACOMA, WASHINGTON


REVISION DATE

9

DATE 03.25.22 JOB NO. 22-022


AS-BUILT DRAWINGS
00% PROGRESS
LATEST SET REVISION

10 A100
WHITE

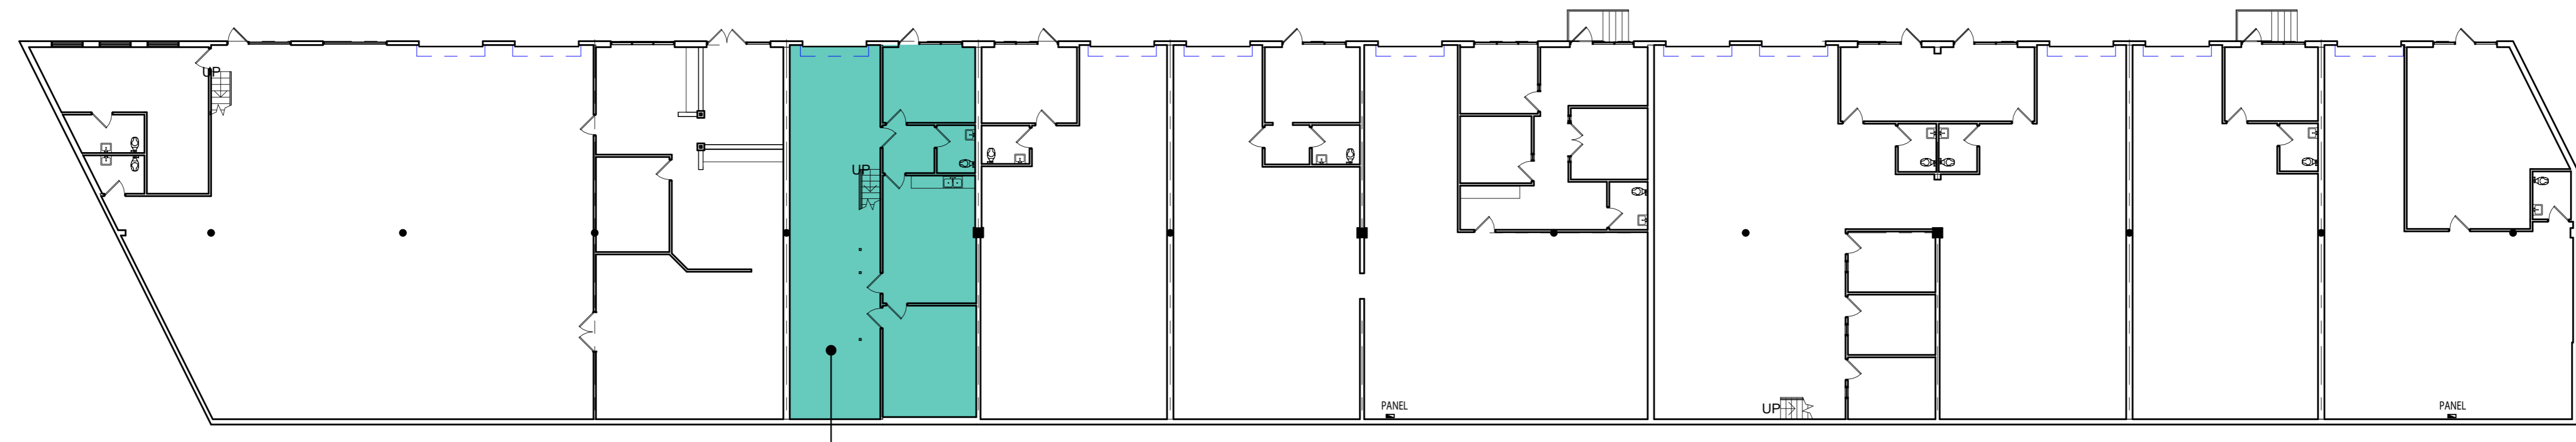

Suite D
1,800 SF
(909 SF ofc)

5A LOWER FLOOR PLAN - 3635 S Lawrence Street
1/16" = 1'-0"

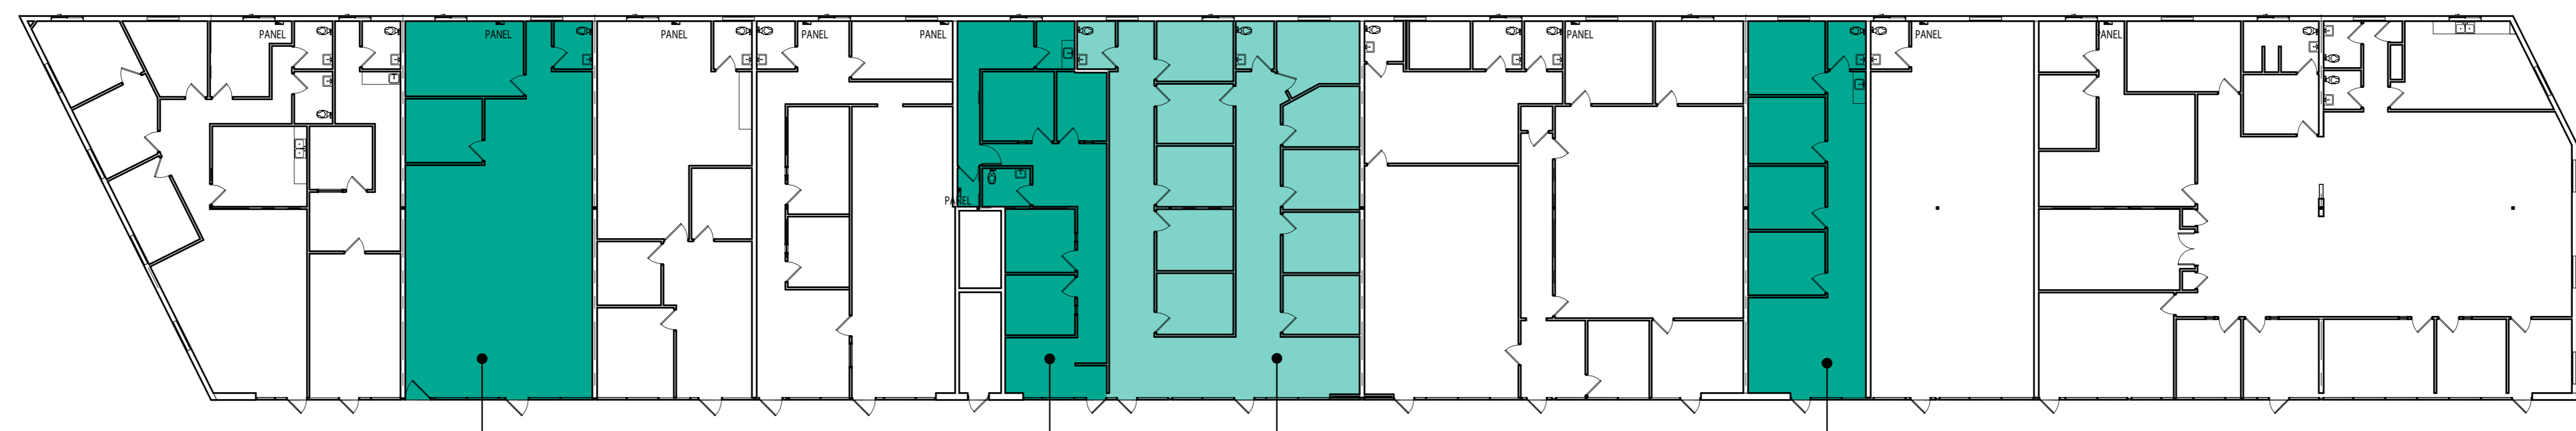

Suite U
1,800 SF


Suite P
1,240 SF

Suite M/O
2,427 SF

Suite H
1,200 SF

10A UPPER FLOOR PLAN - 3640 S Cedar Street
1/16" = 1'-0"

Cedar Plaza - Building D
3635 South Lawrence Street & 3640 South Cedar Street, Tacoma, WA 98409

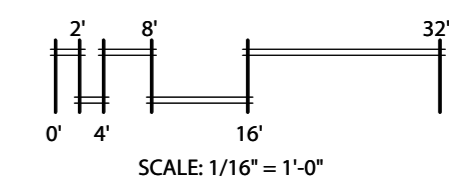

4/6/2022 9:58:16 AM PROJECT: 22-022 - CEDAR PLAZA
\\hp1r\file1\Projects\Cedar Plaza\22-022 Cedar Plaza AS-Built\01 Drawings\03 BIM Models\22-022 Cedar Plaza AS-Built\BldgD-A_721.rvt

DRAWING NO.
©HELIX DESIGN GROUP, INC.: All rights reserved. No part of this document may be reproduced in any form or by any means without permission in writing from Helix Design Group.