

Helix
design group



AMERICAN INSTITUTE OF ARCHITECTS

3

HELIX DESIGN GROUP, INC

4

5

6

7 FLOOR PLAN

8 CEDAR PLAZA
BUILDING A

TACOMA, WASHINGTON

REVISION DATE


9

DATE 03.25.22 JOB NO. a22-022

AS-BUILT DRAWINGS
00% PROGRESS
LATEST SET REVISION

10 A100
WHITE


DRAWING NO.
© HELIX DESIGN GROUP, INC.: All rights reserved. No part of this document may be reproduced in any form or by any means without permission in writing from Helix Design Group.

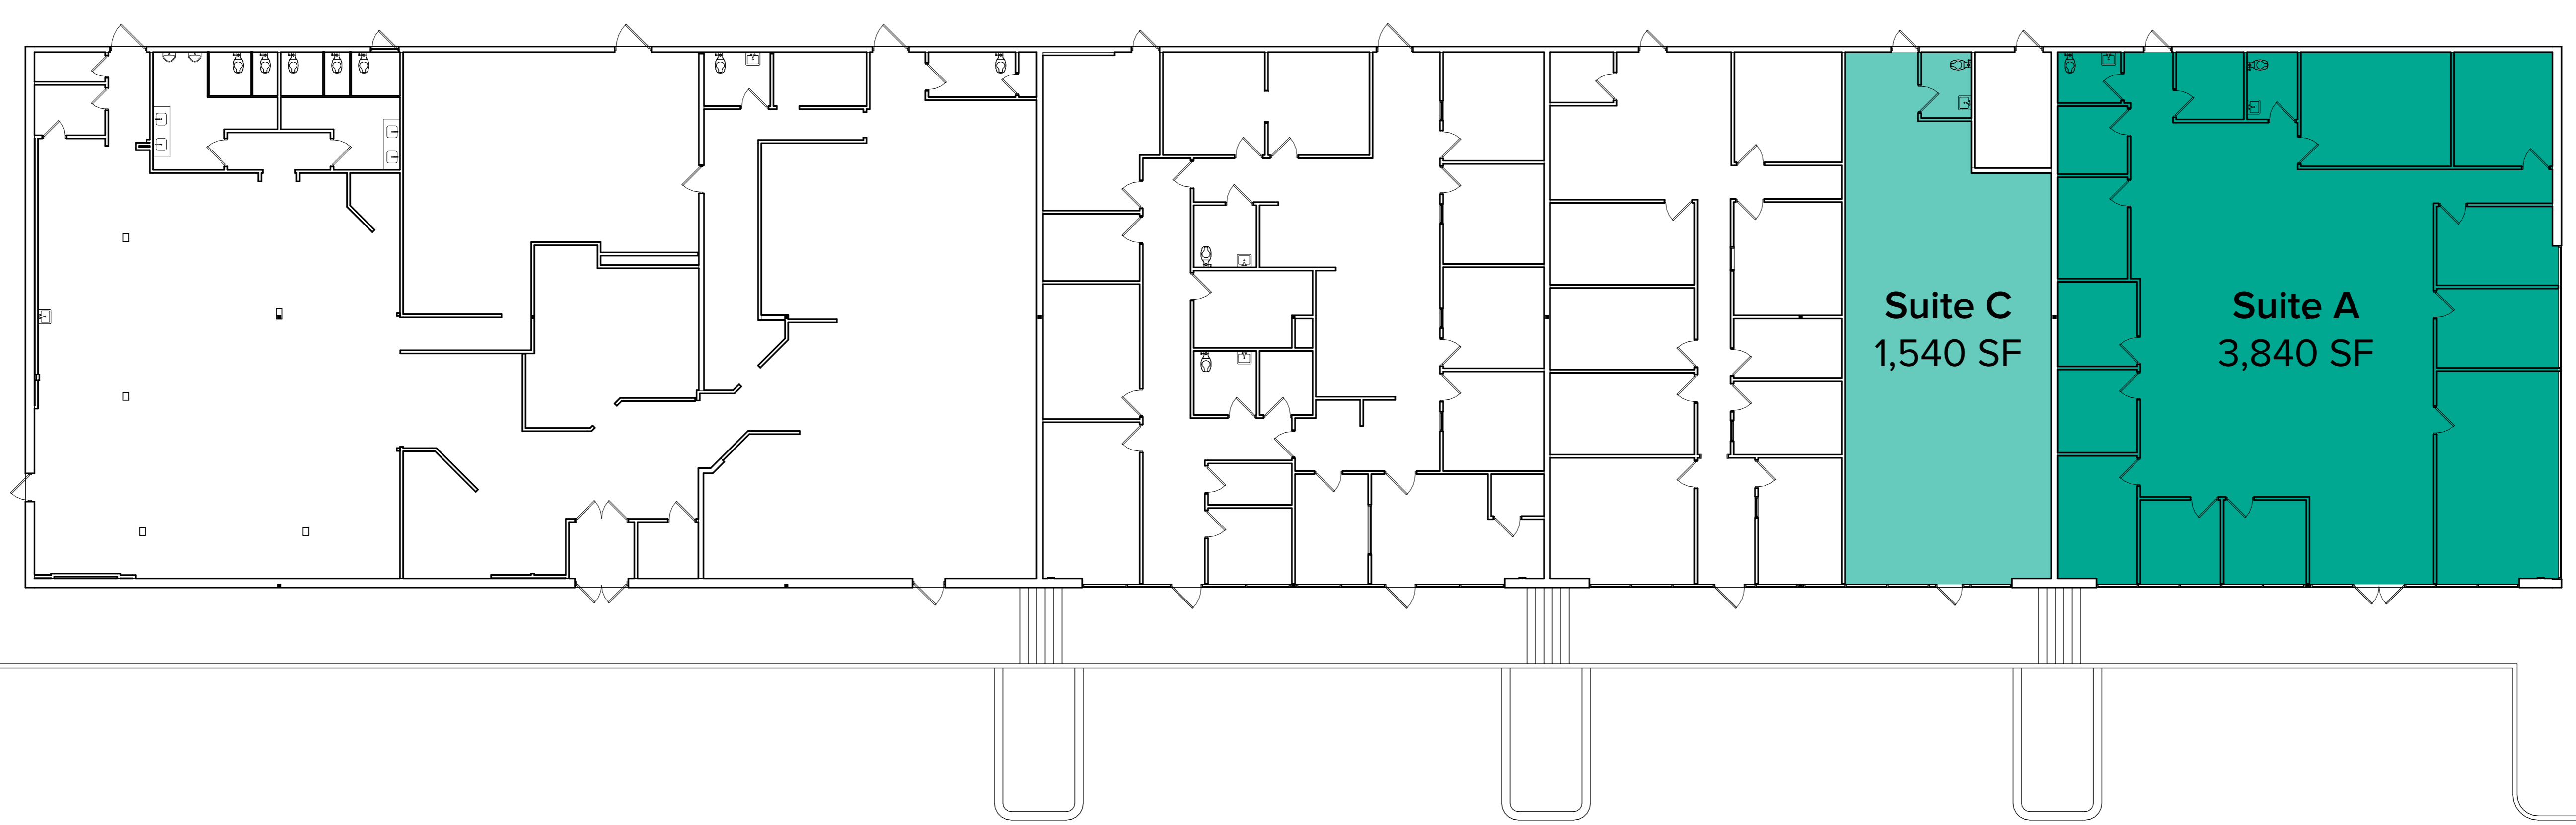

PROJECT: 422-022 - CEDAR PLAZA
P:\Cedar Plaza\422-022 Cedar Plaza A-Building A Drawings\03 BIM Models\422-022 Cedar Plaza A-Building A.rvt
PLOT: 4/6/2022 10:58:20 AM
FILE PATH:

Cedar Plaza - Building A

3630 South Cedar Street, Tacoma, WA 98409

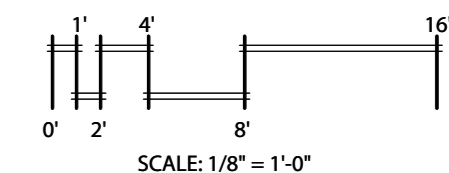

10