

Helix
design group



AMERICAN INSTITUTE OF ARCHITECTS

3

HELIX DESIGN GROUP, INC

4

5

6

7 FLOOR PLAN

8 CEDAR PLAZA
BUILDING B


TACOMA, WASHINGTON

REVISION	DATE
DATE	JOB NO.
02.10.22	q22-001

AS-BUILT DRAWINGS
00% PROGRESS
LATEST SET REVISION

9
A100
WHITE


DRAWING NO.
© HELIX DESIGN GROUP, INC.: All rights reserved. No part of this document may be reproduced in any form or by any means without permission in writing from Helix Design Group.

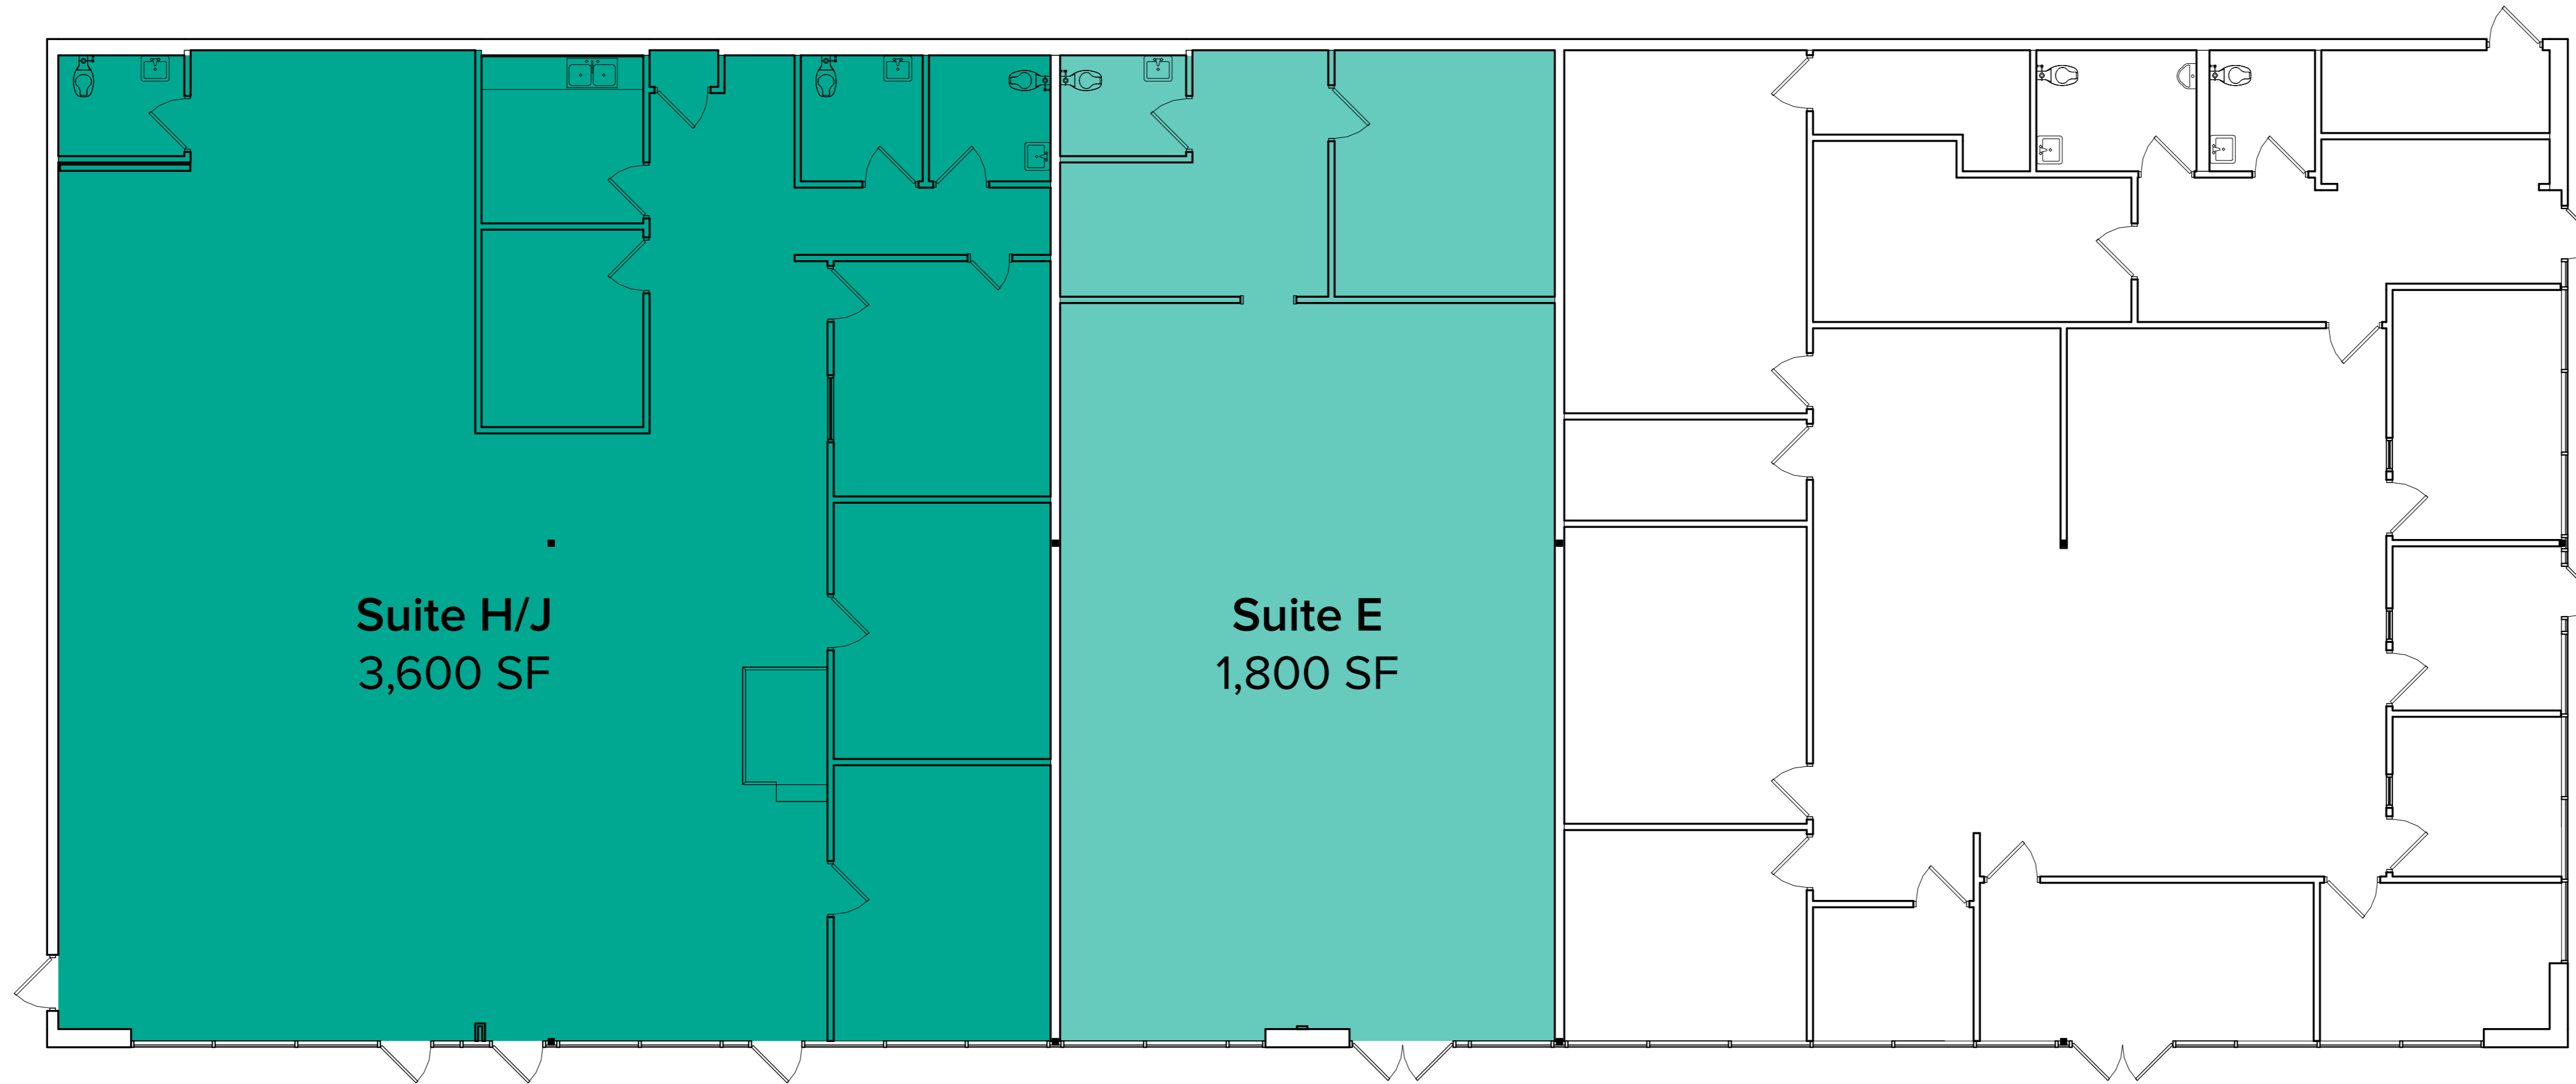

Cedar Plaza - Building B

3680 South Cedar Street, Tacoma, WA 98409

10C FLOOR PLAN
1/16" = 1'-0"

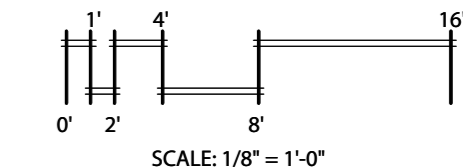

PLOTTED: 4/6/2022 10:55:14 AM
 FILE PATH: P:\Cedar Plaza\q22-002 Cedar Plaza As-Built\01 Drawings\03 BIM Models\q22-002 Cedar Plaza As-Built\03 BIM Models\10C.q22.rvt