

**Helix**  
design group



AMERICAN INSTITUTE OF ARCHITECTS

3

HELIX DESIGN GROUP, INC

4

5

6

7 FLOOR PLAN


8 CEDAR PLAZA  
BUILDING B

TACOMA, WASHINGTON

REVISION	DATE
DATE	JOB NO.
02.10.22	q22-001

9  
AS-BUILT DRAWINGS  
00% PROGRESS  
LATEST SET REVISION


10 A100  
WHITE

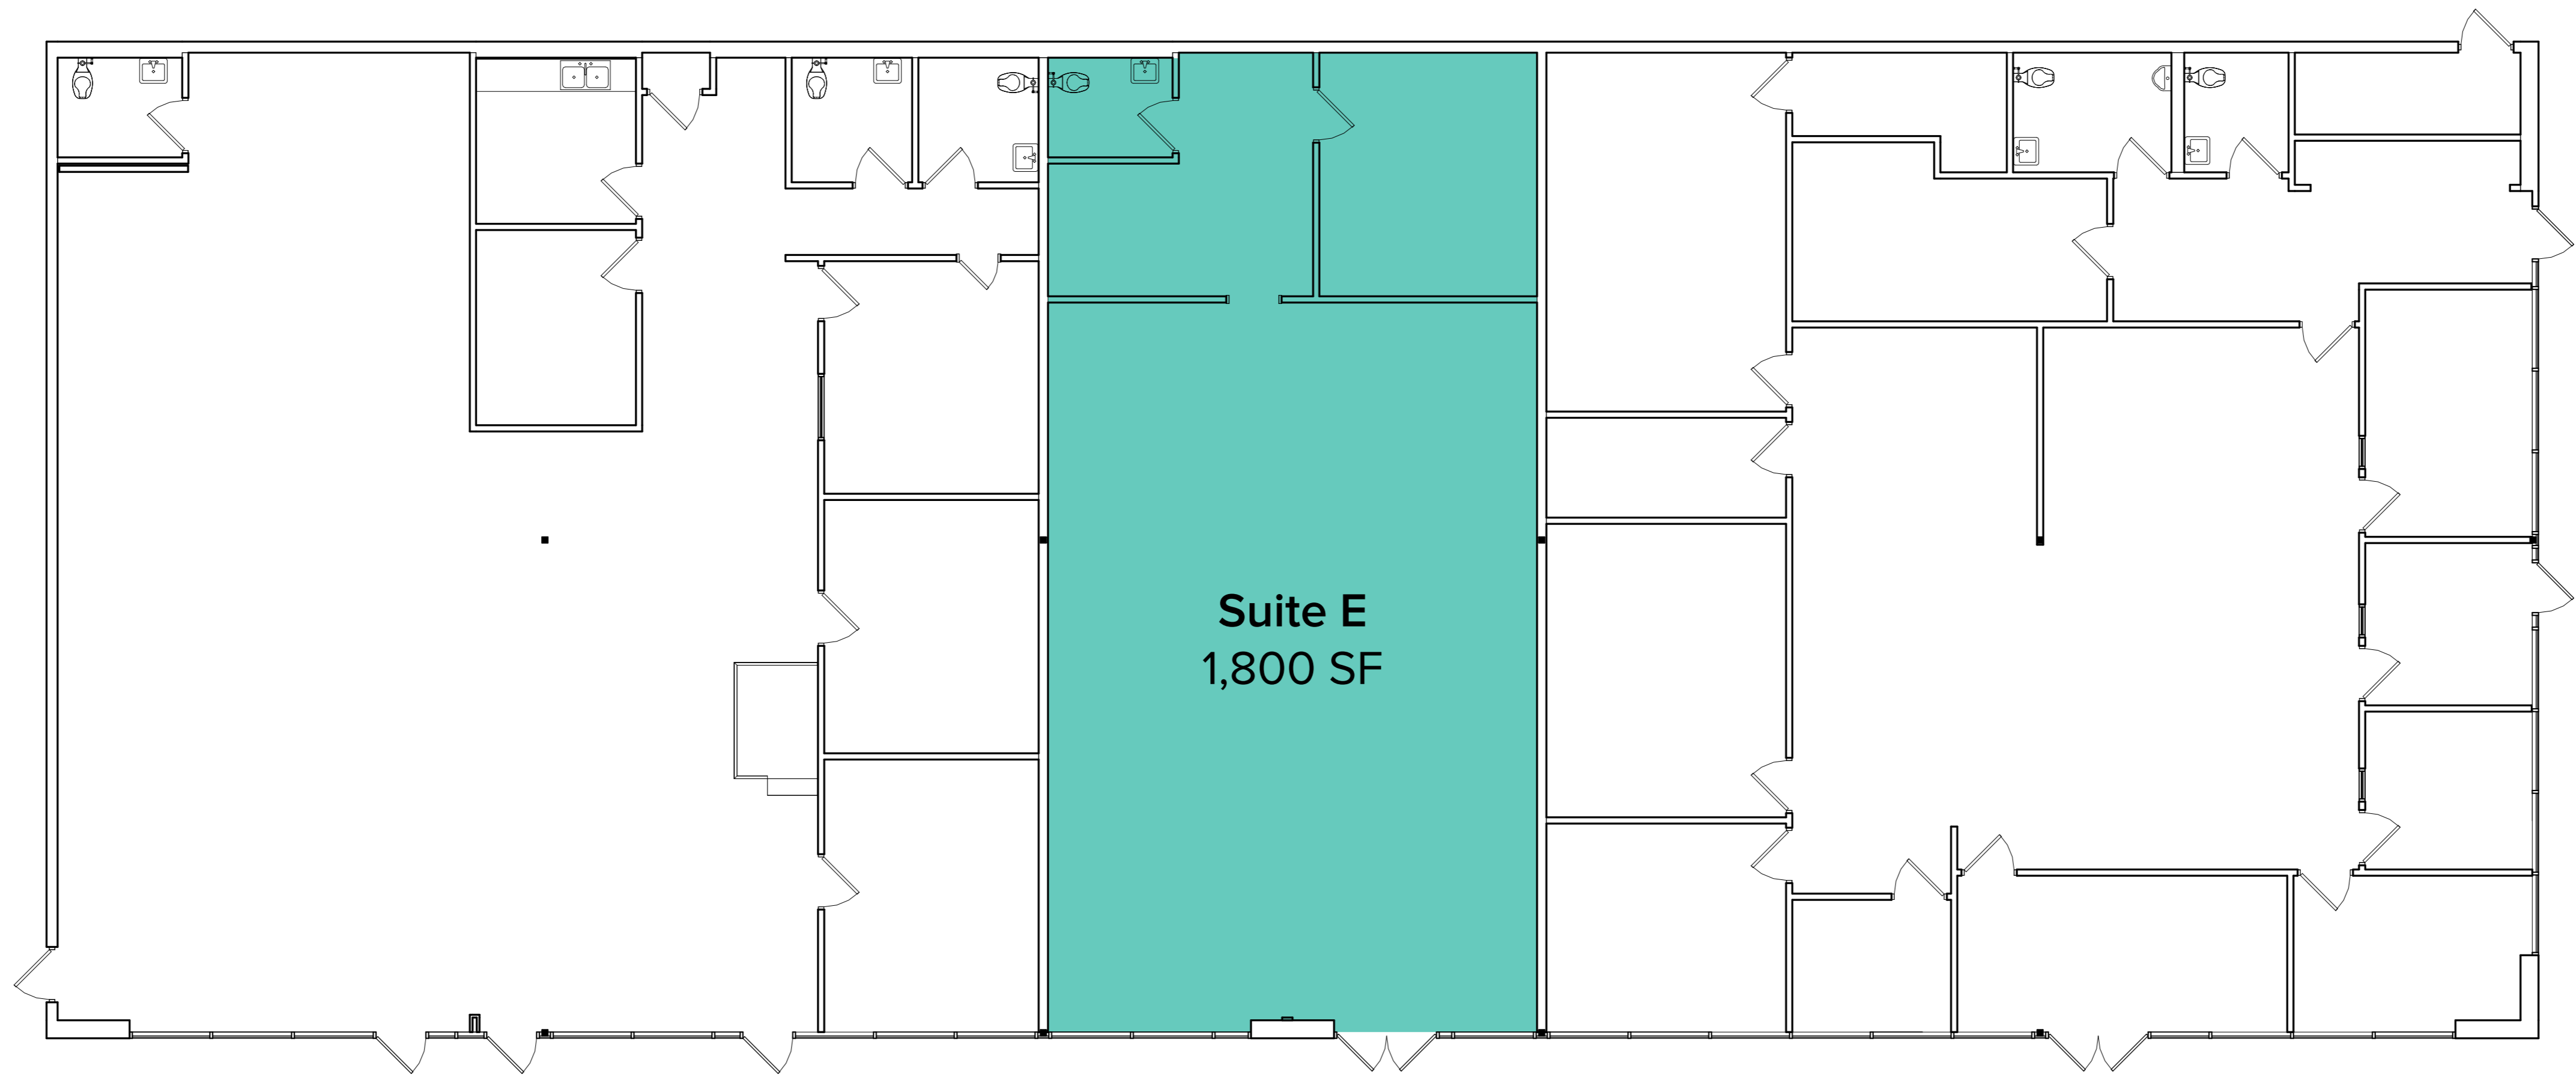

# Cedar Plaza - Building B

## 3680 South Cedar Street, Tacoma, WA 98409

100 FLOOR PLAN  
1/16" = 1'-0"

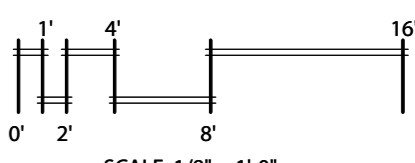

PLOTTED: 4/6/2022 10:55:14 AM  
FILE PATH: P:\Cedar Plaza\q22-001 Cedar Plaza As-Built\101 Drawings\03 BIM Models\q22-001 Cedar Plaza As-Built\101.dwg

DRAWING NO.  
© HELIX DESIGN GROUP, INC.: All rights reserved. No part of this document may be reproduced in any form or by any means without permission in writing from Helix Design Group.