


**Helix**  
design group




AMERICAN INSTITUTE OF ARCHITECTS

HELIX DESIGN GROUP, INC

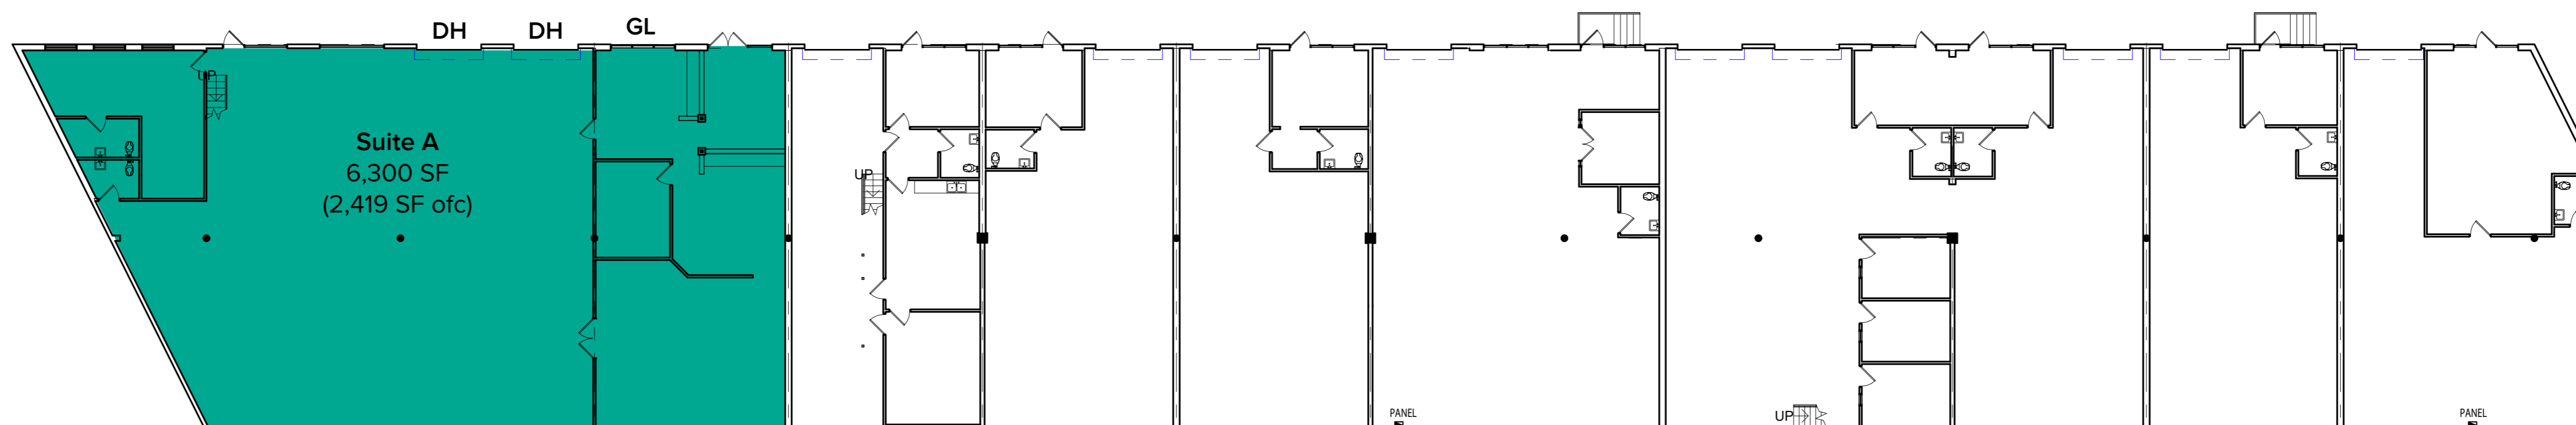

5A LOWER FLOOR PLAN - 3635 S Lawrence Street  
1/16" = 1'-0"

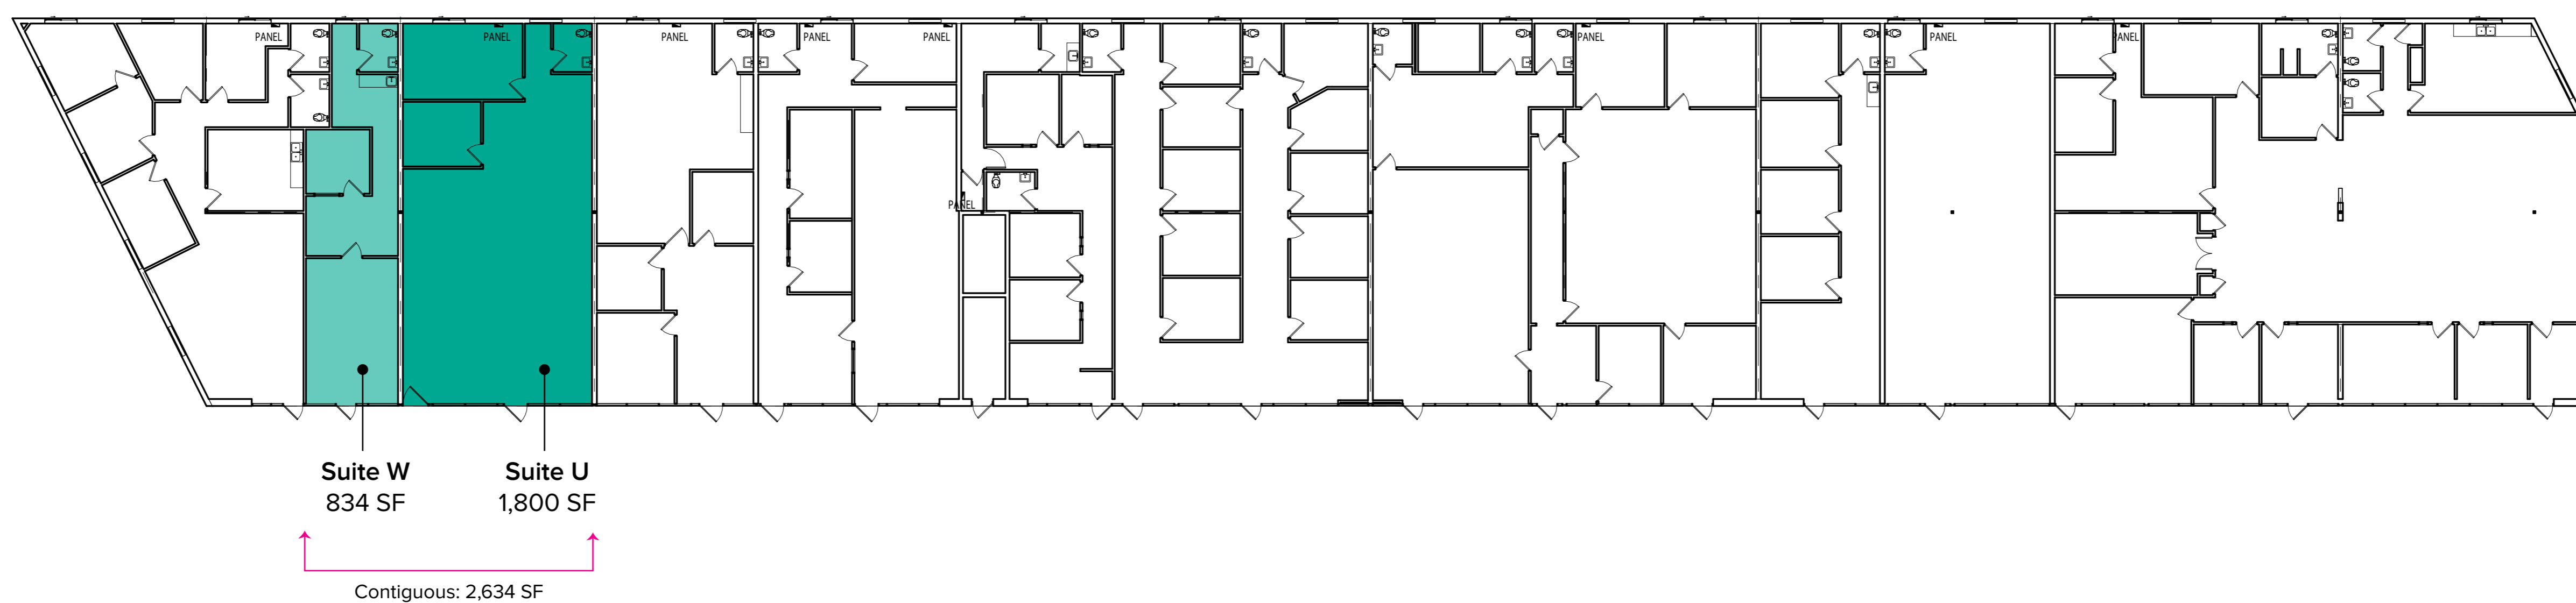

10A UPPER FLOOR PLAN - 3640 S Cedar Street  
1/16" = 1'-0"


1  
2  
3  
4  
5  
6  
7 FLOOR PLAN  
8 CEDAR PLAZA BUILDING D  
TACOMA, WASHINGTON

REVISION	DATE

DATE 03.25.22 JOB NO. 22-022  
AS-BUILT DRAWINGS  
07% PROGRESS  
LATEST SET REVISION

10 A100  
WHITE  
DRAWING NO.

Cedar Plaza - Building D  
3635 South Lawrence Street & 3640 South Cedar Street, Tacoma, WA 98409

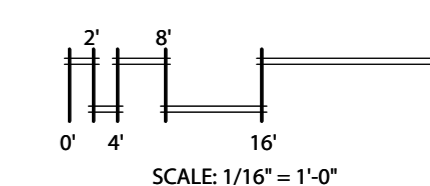

PLOTTED: 4/6/2022 9:58:16 AM PROJECT: 22-022 - CEDAR PLAZA  
 \\hdp-ff-file1\Projects\Cedar Plaza\22-022 Cedar Plaza AS-Built\01 Drawings\03 BIM Models\22-022 Cedar Plaza AS-Built\BD\10A\_722.rvt

© HELIX DESIGN GROUP, INC.: All rights reserved. No part of this document may be reproduced in any form or by any means without permission in writing from Helix Design Group.