

Helix
design group



AMERICAN INSTITUTE OF ARCHITECTS

3

HELIX DESIGN GROUP, INC

4

5

6

7 BOMA PLANS

8 GOLDEN STONE
OFFICE BUILDING
33400 9TH
AVENUE SOUTH


FEDERAL WAY, WASHINGTON
REVISION DATE

9

DATE 06.29.22 JOB NO. a22-065
AS-BUILT DRAWINGS

10 G003
WHITE

DRAWING NO.
© HELIX DESIGN GROUP, INC.: All rights reserved. No part of this document may be reproduced in any form or by any means without permission in writing from Helix Design Group.

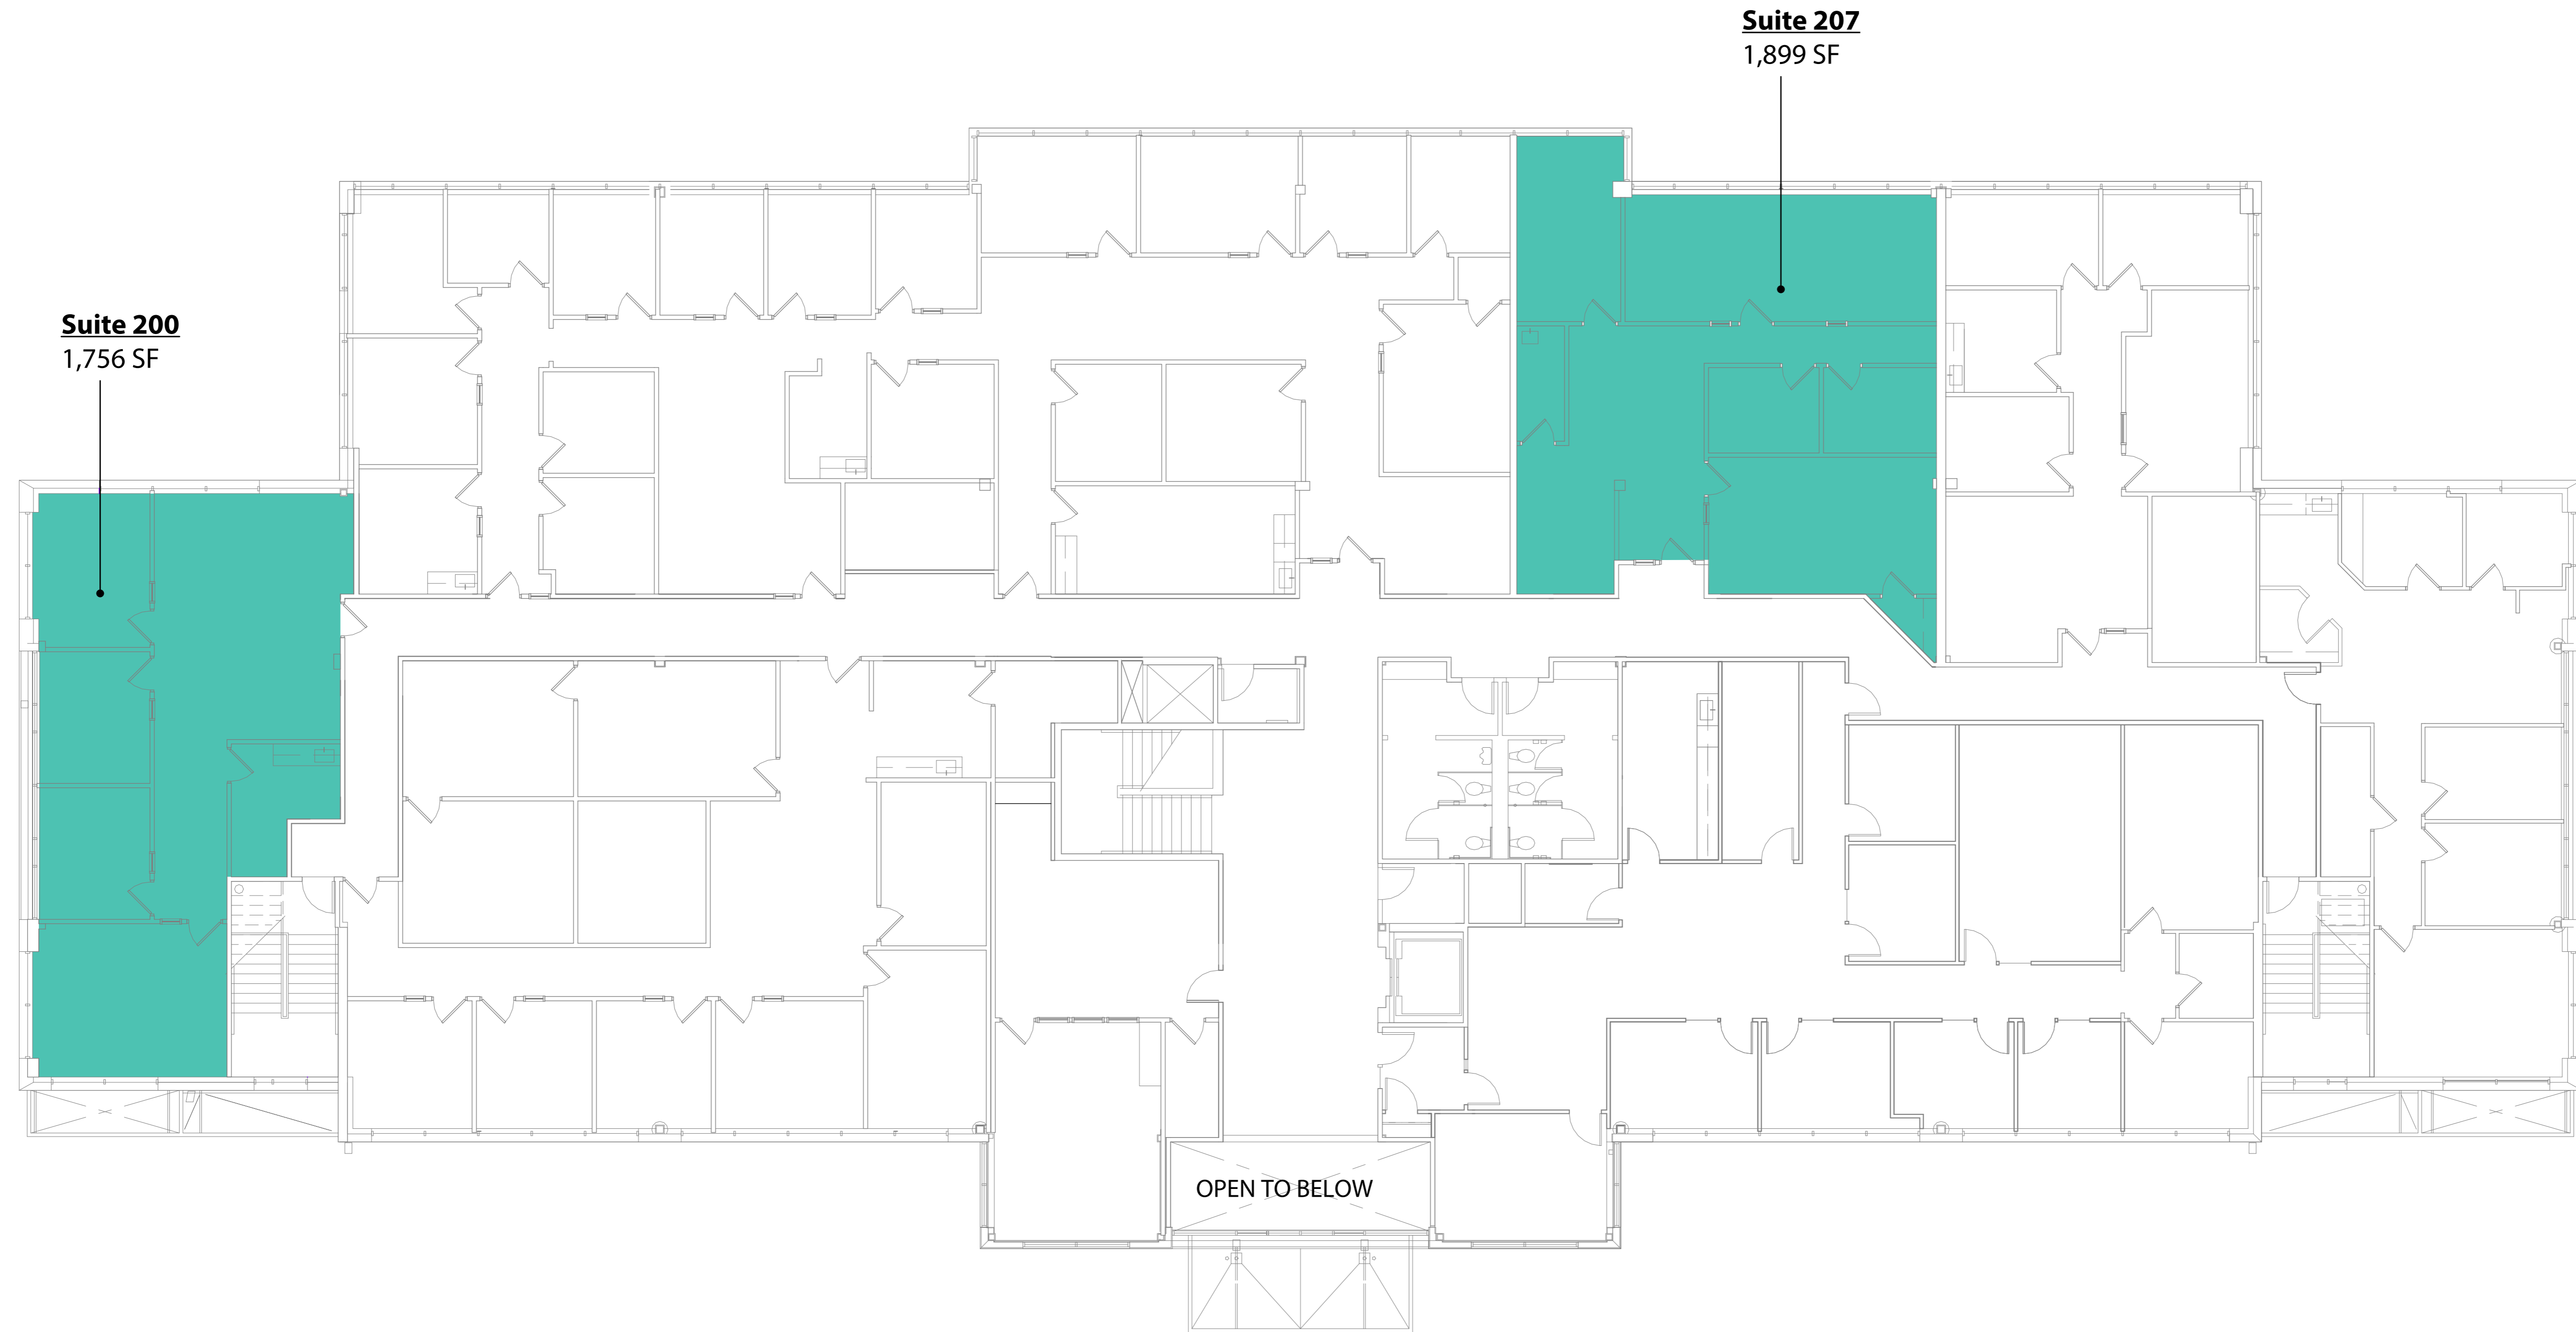

GOLDEN STONE OFFICE BUILDING - Second Floor

33400 9th Ave S, Federal Way, WA 98003



ROSEN HARBOTTLE
COMMERCIAL REAL ESTATE

PROJECT: 422-065 - GOLDEN STONE OFFICE BUILDING
9th Ave As Built - A_122_ellampy/2379.rvt
6/29/2022 3:46:16 PM
C:\Users\ella\Desktop\Revit 2022\Projects\422-065 Golden Stone