

Helix
design group



AMERICAN INSTITUTE OF ARCHITECTS

3

HELIX DESIGN GROUP, INC

4

5

6

7

BOMA PLANS

8

GOLDEN STONE
OFFICE BUILDING
33400 9TH
AVENUE SOUTH

9


FEDERAL WAY, WASHINGTON
REVISION DATE

10

DATE: 06.29.22 JOB NO: a22-065
AS-BUILT DRAWINGS

G003
WHITE

DRAWING NO.
© HELIX DESIGN GROUP, INC.: All rights reserved. No part of this document may be reproduced in any form or by any means without permission in writing from Helix Design Group.

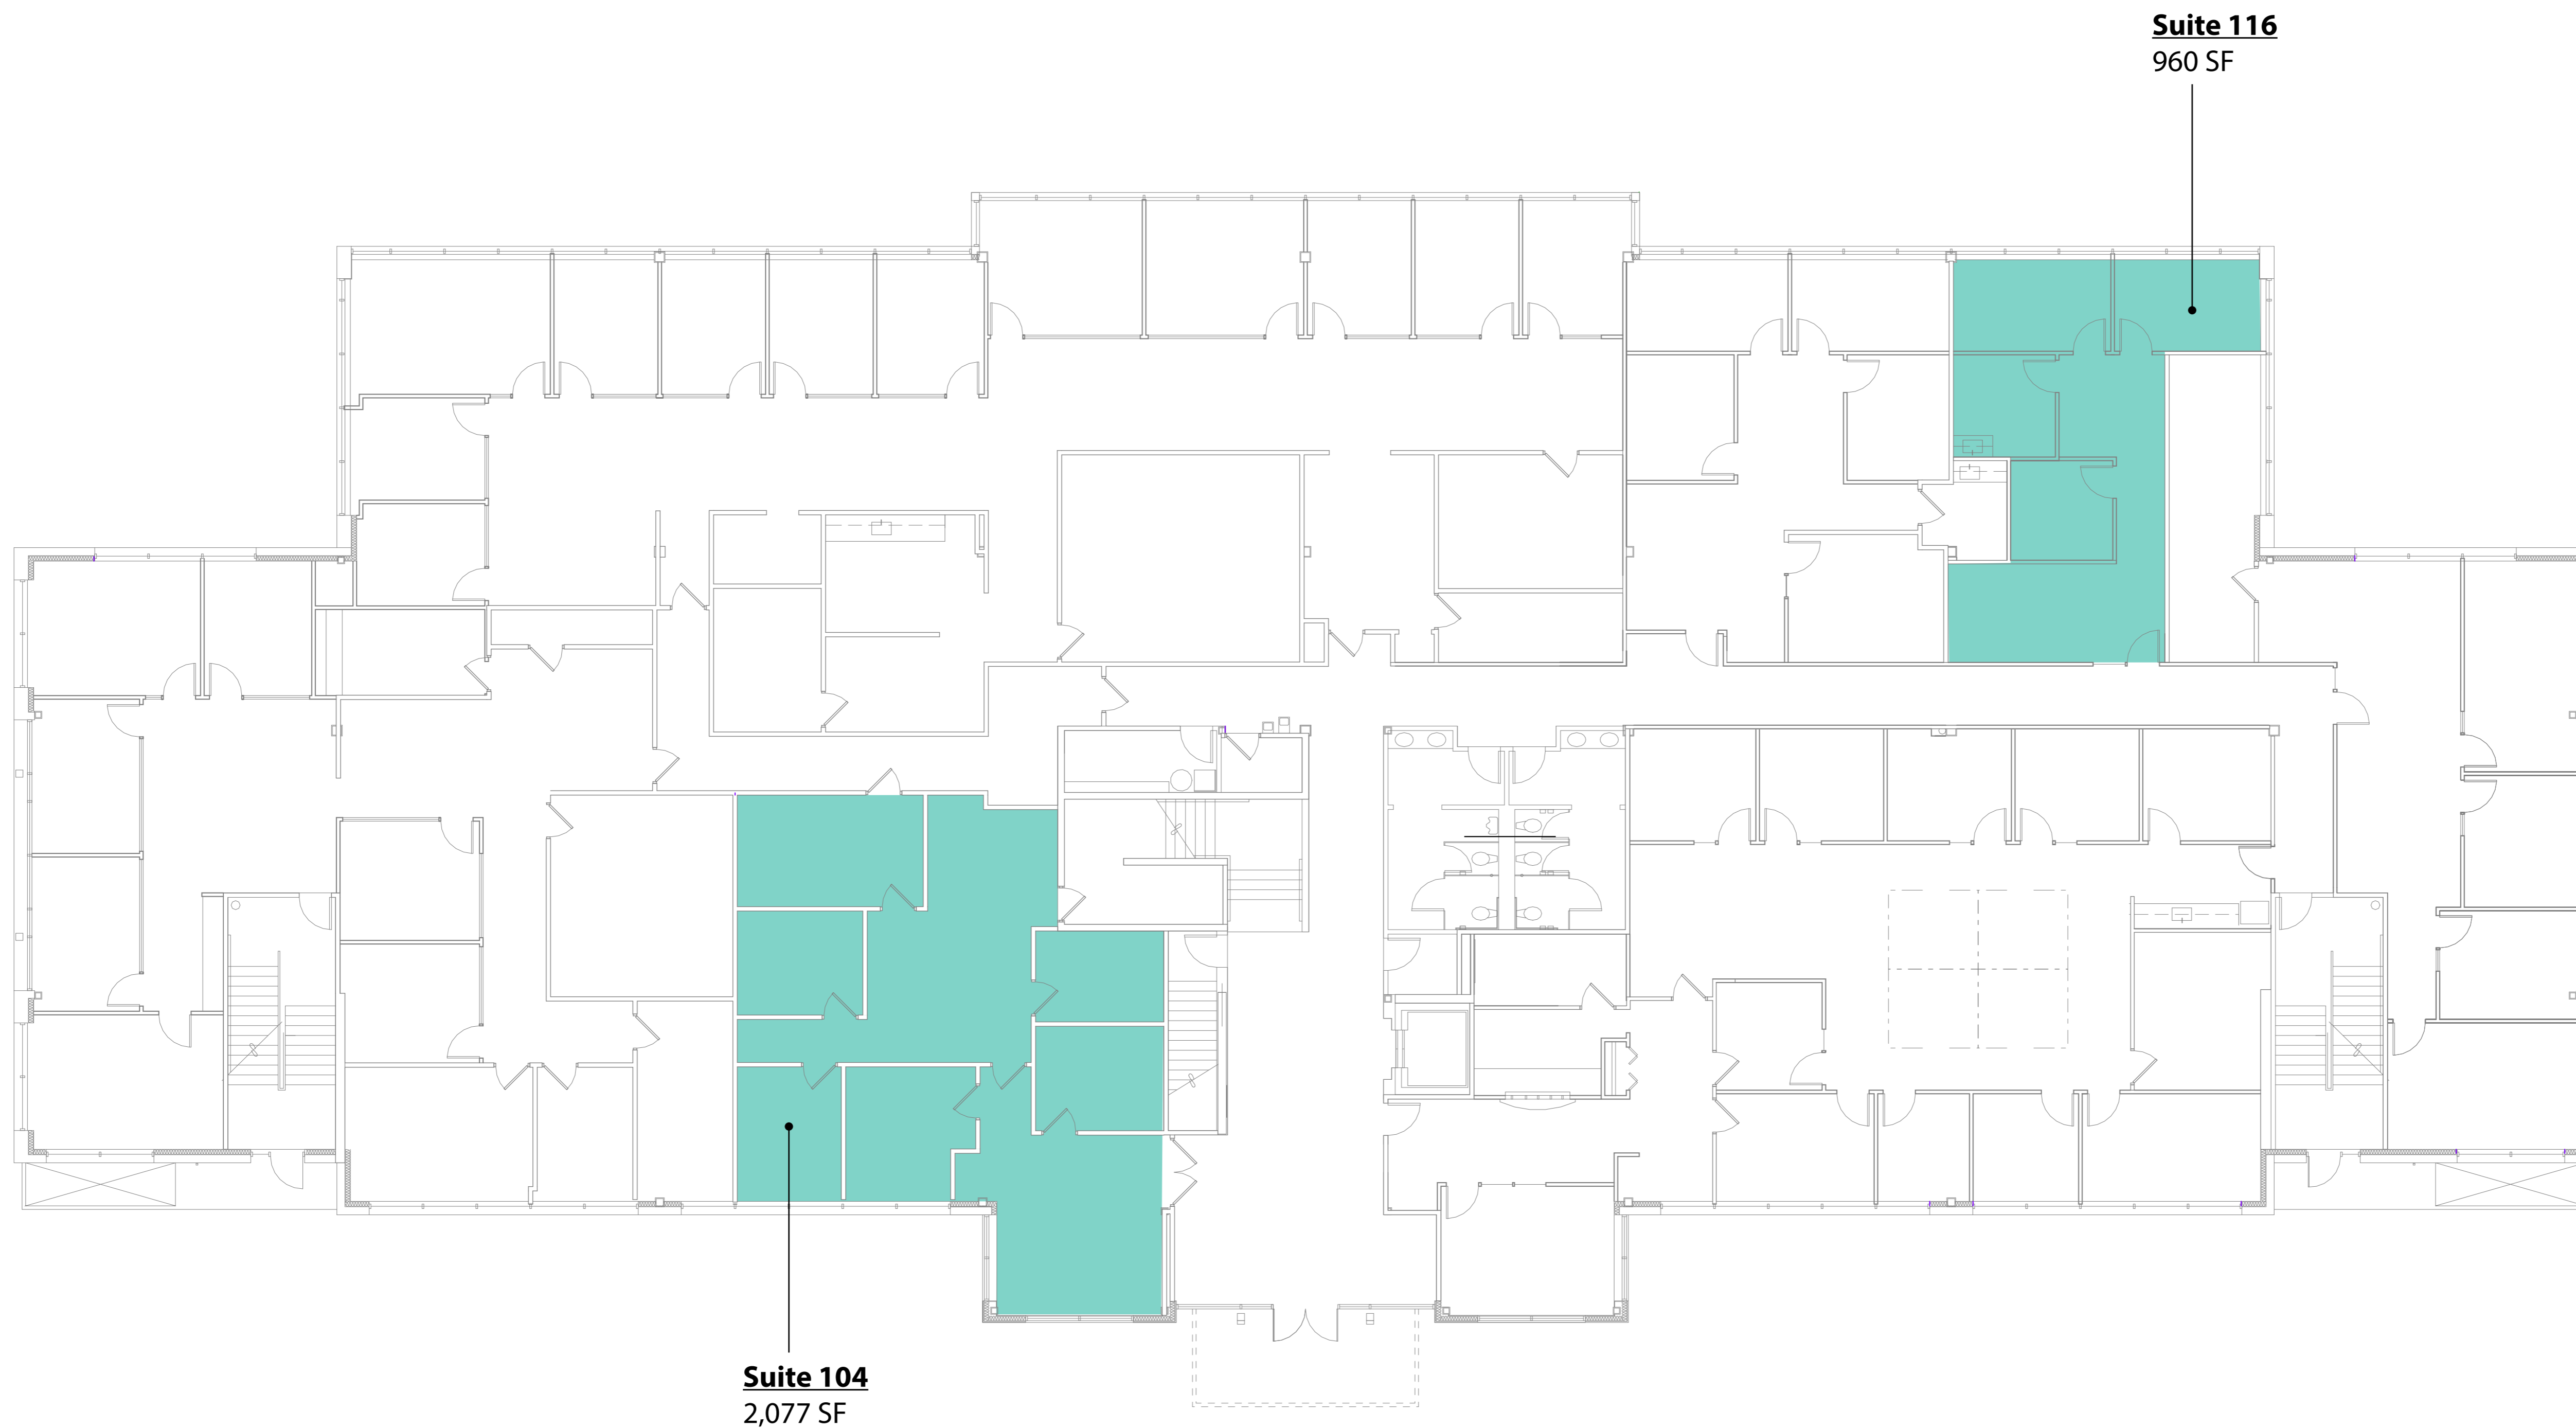

Suite 104
2,077 SF

Suite 116
960 SF

PROJECT: 422-065 - GOLDEN STONE OFFICE BUILDING
9th Ave As Built - A_122_ellalampy/2379.rvt
6/29/2022 3:46:16 PM
FILE PATH: C:\Users\ellalampy\Desktop\Revit 2022\Projects\422-065 Golden Stone

GOLDEN STONE OFFICE BUILDING - First Floor

33400 9th Ave S, Federal Way, WA 98003



ROSEN HARBOTTLE
COMMERCIAL REAL ESTATE