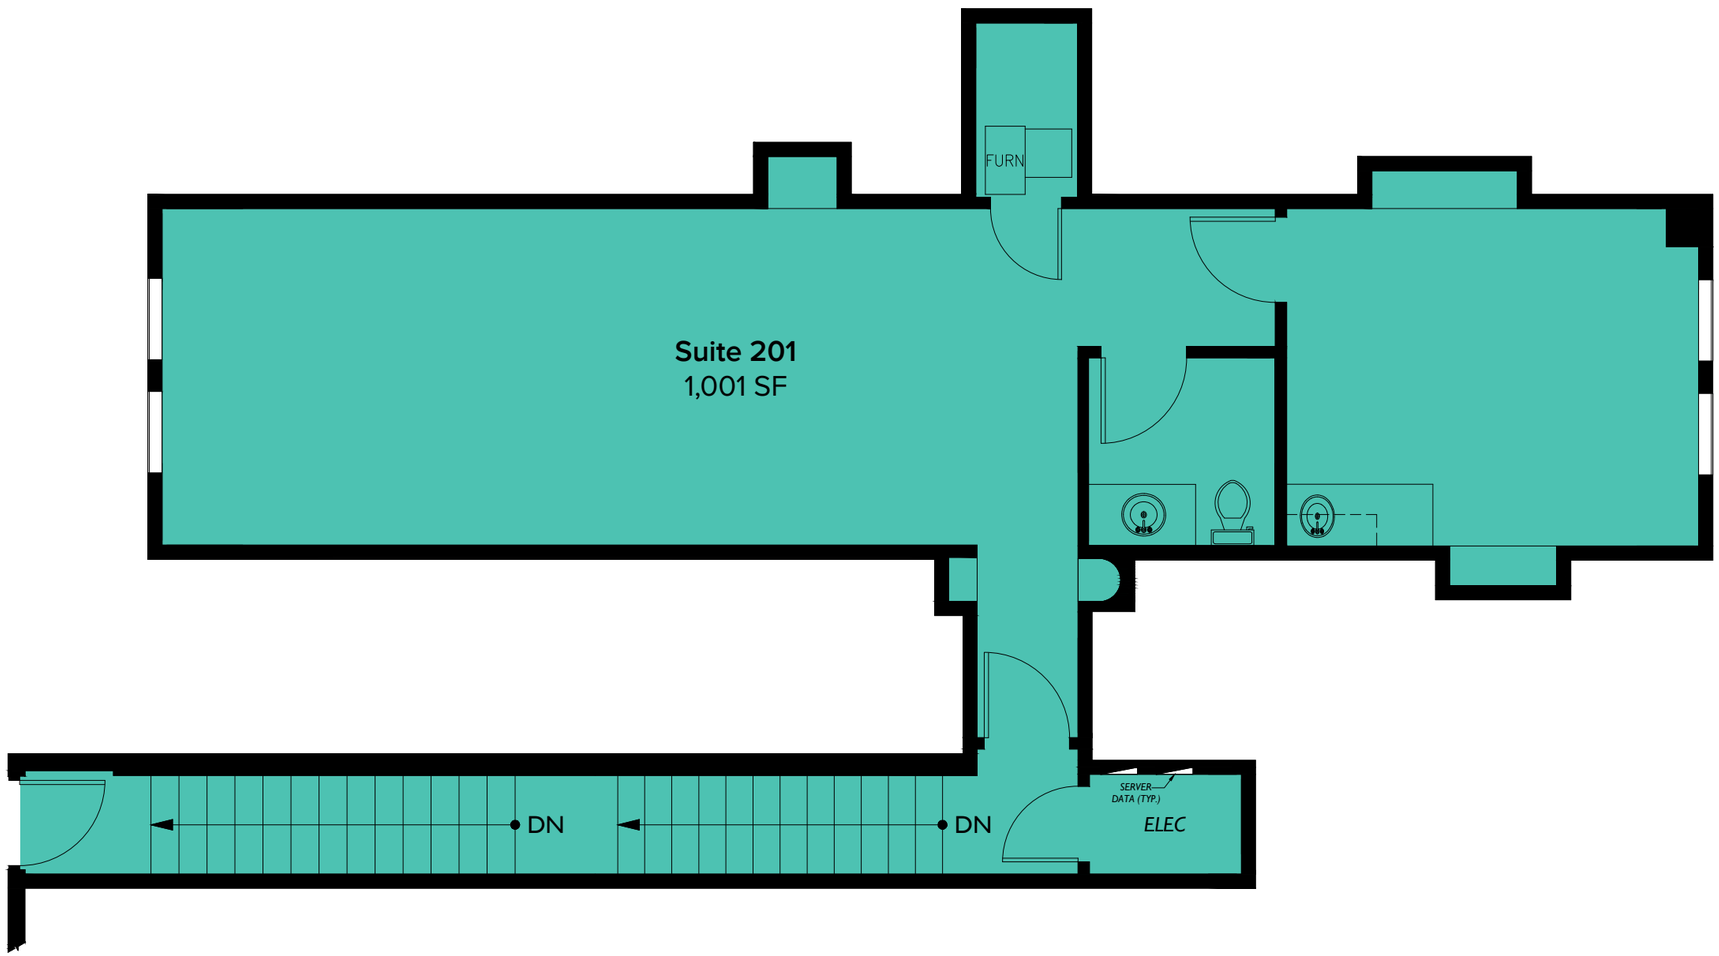

0 5 10 15

Scale: 3/16" = 1'-0"

2-D AS-BUILT FLOOR PLANS

2DFLOORPLANS.COM

371 NW Gilman Blvd.
Suite 140
Issaquah, WA 98027
425-677-7511

This drawing is an instrument of service and is the sole property of the client listed. Any alteration of this drawing without removal of references to 2-D As-Built Floor Plans, Inc. is prohibited.

Drawing scale and dimensions are provided for reference only. Refer to CAD files for exact measurements.

©2010 2-D As-Built Floor Plans, Inc. All Rights Reserved.

Project: C23-225

Date	Action
Project	
02/27/2023	Initial Suite Measure
C23-225	

Client:
Lakeshore Corporation
613 Market Street
Kirkland, WA 98033

Site:
Retail Suite
17408 WA-9
Snohomish, WA 98296

Floor Plan

1

Floor