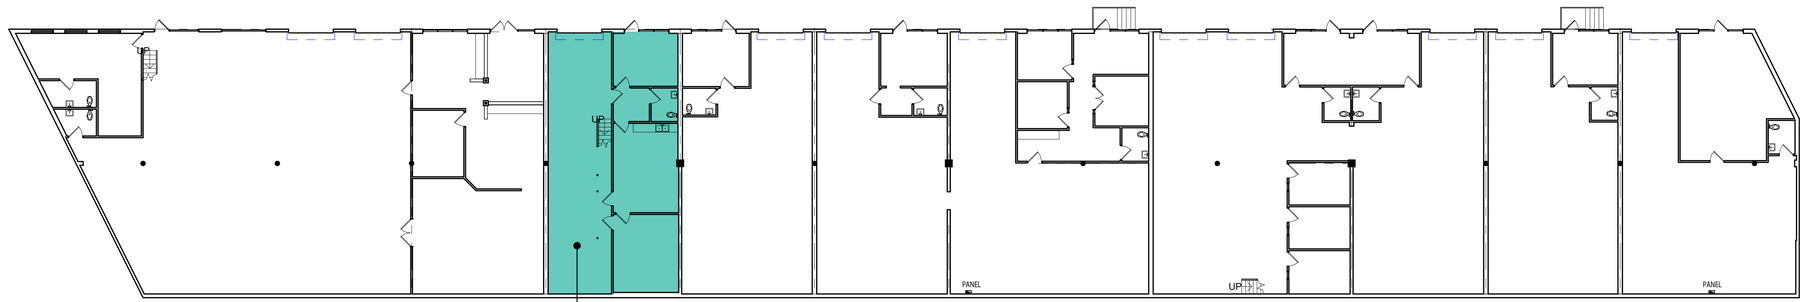

Suite D
1,800 SF
(909 SF ofc)

5A LOWER FLOOR PLAN - 3635 S Lawrence Street
1/16" = 1'-0"

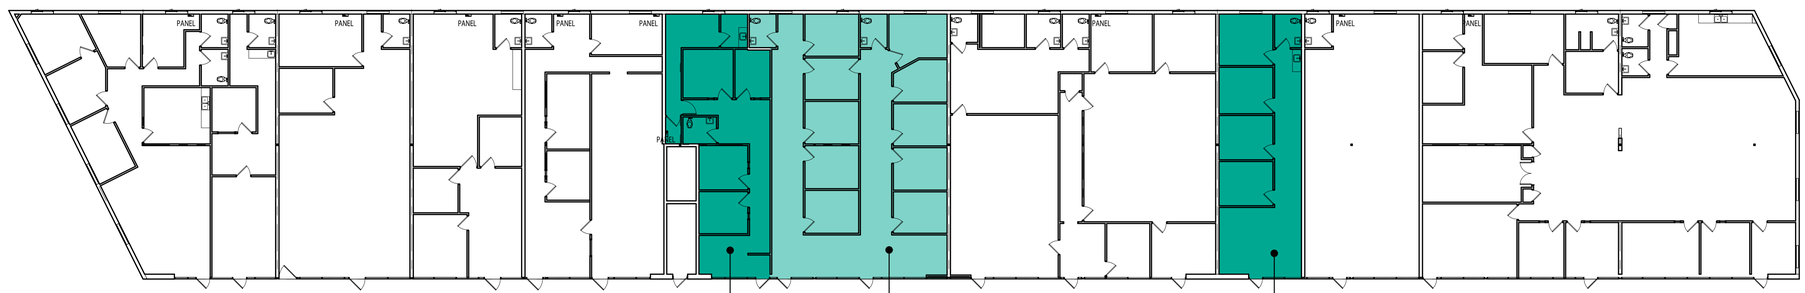

Suite P
1,240 SF

Suite M/O
2,427 SF

Suite H
1,200 SF

10A UPPER FLOOR PLAN - 3640 S Cedar Street
1/16" = 1'-0"

Cedar Plaza - Building D
3635 South Lawrence Street & 3640 South Cedar Street, Tacoma, WA 98409

ROSEN HARBOTTLE
COMMERCIAL REAL ESTATE

NORTH

0' 4' 16' 32'
SCALE: 1/16" = 1'-0"

Helix
design group

AMERICAN INSTITUTE OF ARCHITECTS

HELIX DESIGN GROUP, INC

FLOOR PLAN

CEDAR PLAZA
BUILDING D

TACOMA, WASHINGTON

REVISION	DATE

DATE	JOB NO.
03.25.22	a22-022

AS-BUILT DRAWINGS
00% PROGRESS
LATEST SET REVISION

A100
WHITE
DRAWING NO.

© HELIX DESIGN GROUP, INC.: All rights reserved. No part of this document may be reproduced in any form or by any means without permission in writing from Helix Design Group.

PLOTTED: 4/6/2022 9:58:16 AM
PROJECT: a22-022 - CEDAR PLAZA
\\hdg-fil-file1\Projects\Cedar Plaza\a22-022 Cedar Plaza As-Built's\01 Drawings\03 BIM Models\a22-022 Cedar Plaza As-Built's- Bldg\D-A_r22.rvt