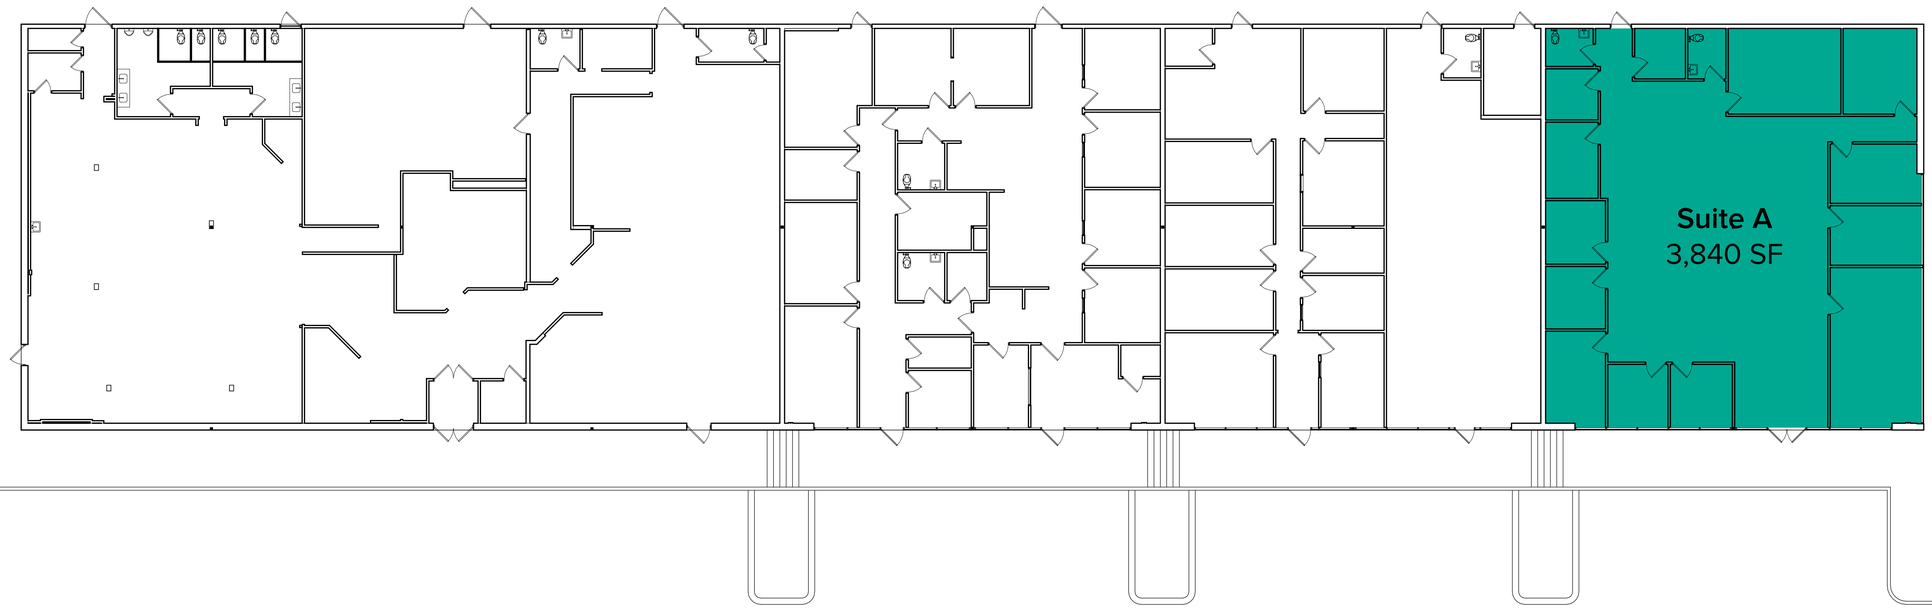

Cedar Plaza - Building A

3630 South Cedar Street, Tacoma, WA 98409

ROSEN HARBOTTLE
COMMERCIAL REAL ESTATE

NORTH

0' 2' 4' 8' 16'

SCALE: 1/8" = 1'-0"

Helix
design group

AMERICAN INSTITUTE OF ARCHITECTS

HELIX DESIGN GROUP, INC

FLOOR PLAN

CEDAR PLAZA
BUILDING A

TACOMA, WASHINGTON

REVISION	DATE

DATE	JOB NO.
03.25.22	a22-022

AS-BUILT DRAWINGS
00% PROGRESS
LATEST SET REVISION

A100
WHITE
DRAWING NO.

© HELIX DESIGN GROUP, INC.: All rights reserved. No part of this document may be reproduced in any form or by any means without permission in writing from Helix Design Group.

PLOTTED: 4/6/2022 10:58:20 AM
FILE PATH: P:\Cedar Plaza\a22-022 Cedar Plaza As-Builts\01 Drawings\03 BIM Models\a22-022 Cedar Plaza As-Builts-BldgA-A_r22.rvt

PROJECT: a22-022 - CEDAR PLAZA