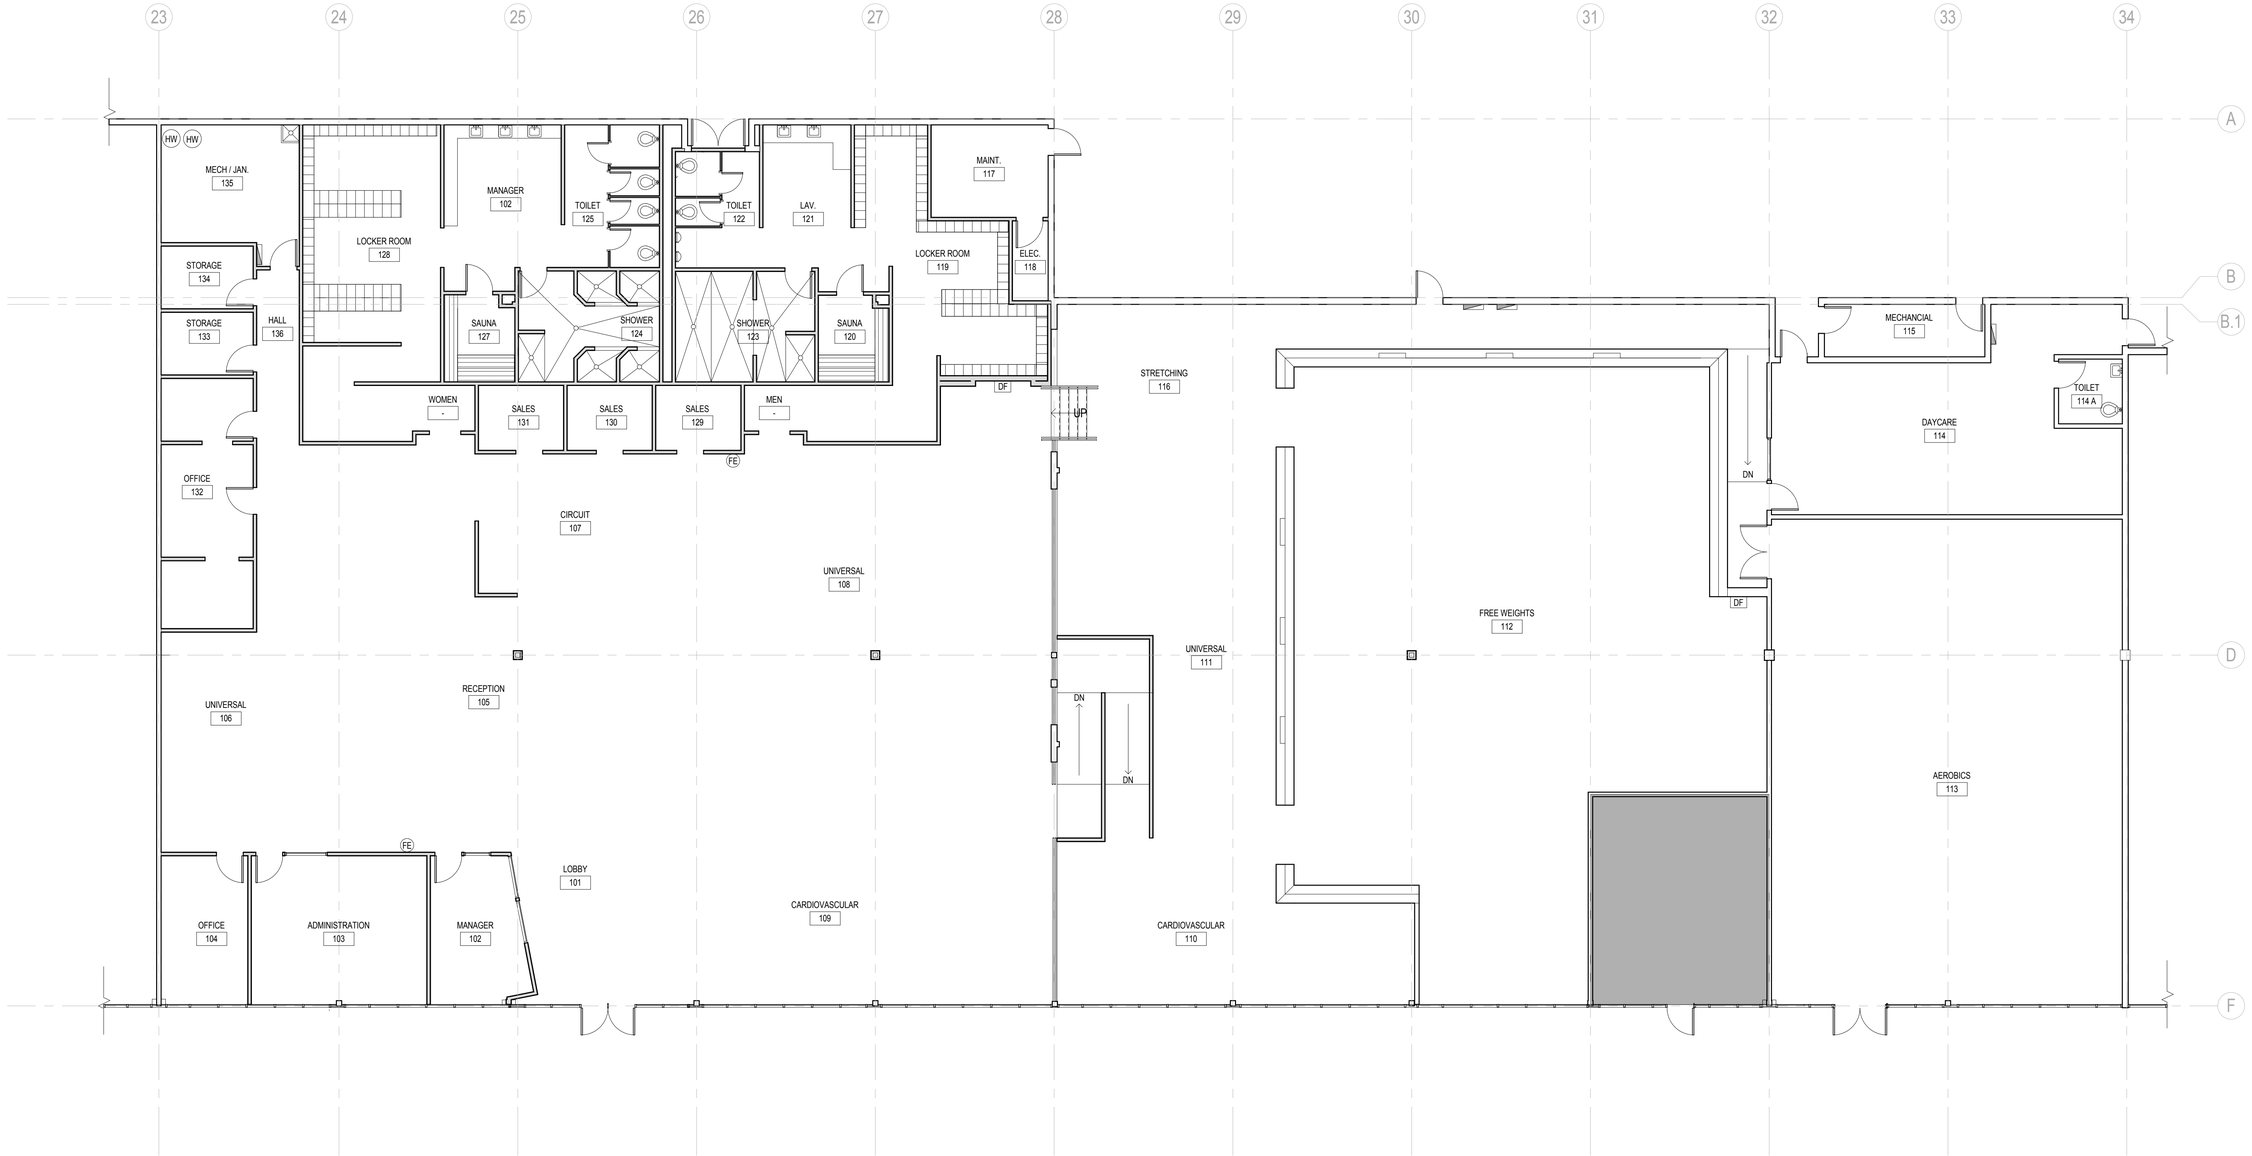

1 / 001 WORK - EXISTING PLAN - 24 HOUR FITNESS
Scale: 1/8" = 1'-0"

0 2' 4' 8'

PRESENTATION TEMPLATE

A16-502

HILLSIDE PLAZA SHOPPING CENTER

AS BUILT DRAWINGS | FEDERAL WAY, WA 98003 11/15/2016

Freiheit & Ho architects