


5A LOWER FLOOR PLAN - 3635 S Lawrence Street

1/16" = 1'-0"

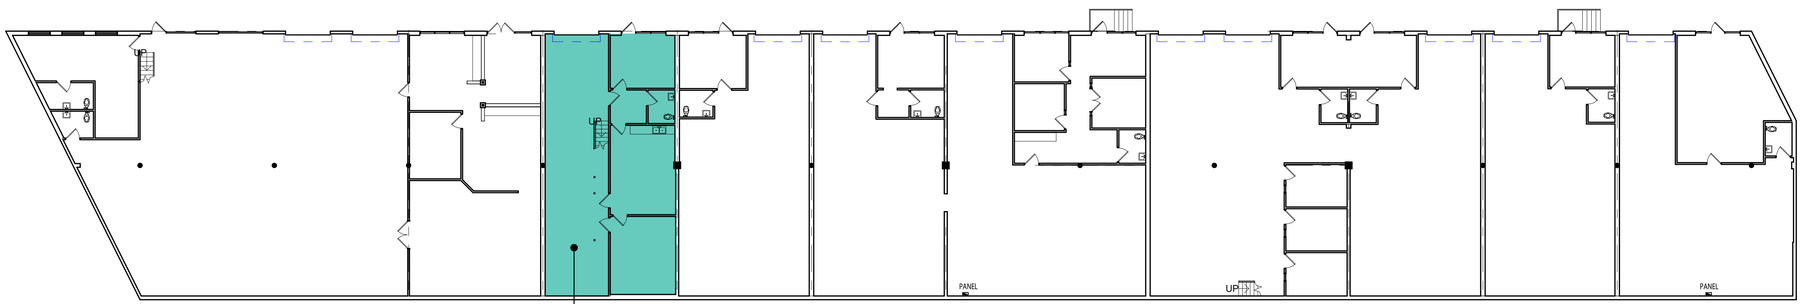


10A UPPER FLOOR PLAN - 3640 S Cedar Street

1/16" = 1'-0"

# Cedar Plaza - Building D

## 3635 South Lawrence Street & 3640 South Cedar Street, Tacoma, WA 98409

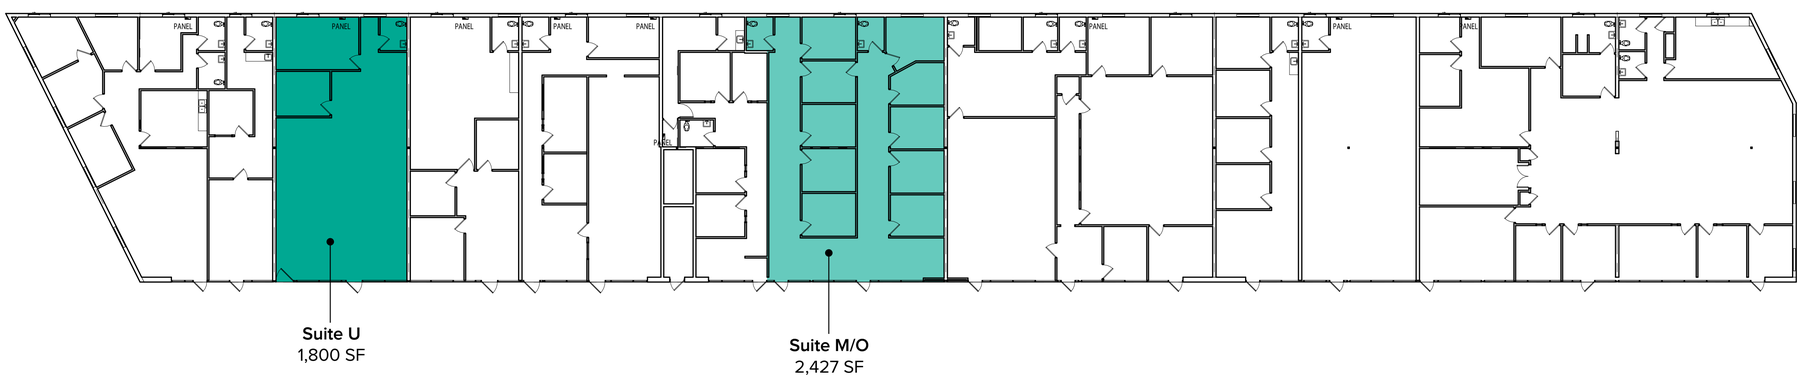ROSEN HARBOTTLE
COMMERCIAL REAL ESTATE

NORTH

0' 4' 8' 16' 32'

SCALE: 1/16" = 1'-0"

Helix design group

AMERICAN INSTITUTE OF ARCHITECTS

HELIX DESIGN GROUP, INC

7 FLOOR PLAN

8 CEDAR PLAZA
BUILDING D

TACOMA, WASHINGTON

| REVISION | DATE |
|---|---|

9

| DATE | JOB NO. |
|---|---|
| 03.25.22 | a22-022 |

AS-BUILT DRAWINGS
00% PROGRESS
LATEST SET REVISION

10 A100

WHITE

DRAWING NO.

© HELIX DESIGN GROUP, INC.: All rights reserved. No part of this document may be reproduced in any form or by any means without permission in writing from Helix Design Group.

PLOTTED: 4/6/2022 9:58:16 AM
PROJECT: a22-022 - CEDAR PLAZA
\\hdg-fil-file1\Projects\Cedar Plaza\a22-022 Cedar Plaza As-Builts\01 Drawings\03 BIM Models\a22-022 Cedar Plaza As-Builts-Bldg D-A_r22.rvt